

WAYNE  
 # 83  
 3-68

MISSISSIPPI  
 BOARD OF WATER COMMISSIONERS  
 416 North State Street  
 Jackson, Mississippi 39201

WATER WELL DRILLERS LOG

March 4 1968 Porter Drilling Co Wayne  
 date well completed firm name county well located

LANDOWNER: Robert Mc Kee

Rt 1 Waynesboro Miss  
 (mailing address)


WELL LOCATION:  
 sec 29 T 9 S R 7 E  
4 miles NW of Waynesboro  
 (distance) (direction) (nearest town)

WELL PURPOSE: domestic  
 (home, irrigation, municipal, industrial)

WELL COMPLETION DATA:

- (1) diameter (inches) 2"
- (2) total depth (feet) 65'
- (3) static water level (feet) 25' below above top of ground.
- (4) casing steel 58'  
 (material) (depth)  
2' if telescope see back.  
 (size)
- (5) screen 5' 60'  
 (length) (depth to top)  
1/4" 8 slot Johnson S.S.  
 (size) (material)
- (6) pump 1/2 8  
 (HP) (yield gpm)  
elec  
 (type power)
- (7) electric log no  
 (yes or no)  
 (organization running log)
- (8) how well bottom plugged flush point


description of formations encountered	from	to
<u>red clay</u>	<u>0</u>	<u>8</u>
<u>chalk</u>	<u>8</u>	<u>40</u>
<u>fine sand</u>	<u>40</u>	<u>52</u>
<u>coarse sand</u>	<u>52</u>	<u>65</u>
<u>stopped with still in sand</u>		

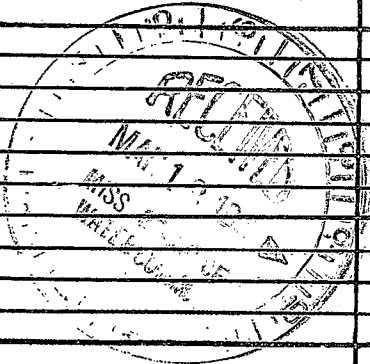

DRILLERS REMARKS:

If well telescopes please sketch and show depths.

GROUND LEVEL

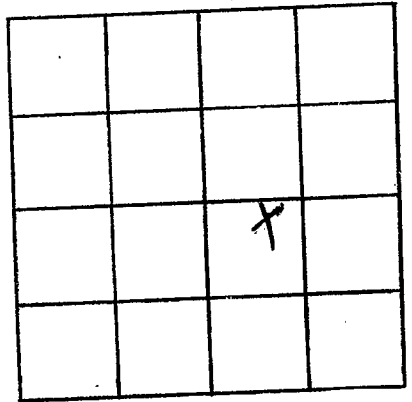

SECTION 29

Please indicate well location X.

ADDITIONAL INFORMATION

If more than one screen, show locations of each on sketch.