

WAYNE  
H84  
3-68

MISSISSIPPI  
BOARD OF WATER COMMISSIONERS  
416 North State Street  
Jackson, Mississippi 39201

WATER WELL DRILLERS LOG

March 5 1968 date well completed  
Boyer Drilling & Inc. firm name  
Wayne county well located

LANDOWNER: Rhoda  
Braham  
P.O. 1 Shubuta Miss  
(mailing address)

description of formations encountered	from	to
	red clay	0
chalk to sand	10	51
sand	51	58
stayed on chalk		


WELL LOCATION:  
sec. 6 T 90 N R 7 E  
S W  
7 miles NW of Waynesboro  
(distance) (direction) (nearest town)

WELL PURPOSE: domestic  
(home, irrigation, municipal, industrial)

- WELL COMPLETION DATA:
- (1) diameter (inches) 2"
  - (2) total depth (feet) 58
  - (3) static water level (feet) 52 below above top of ground.
  - (4) casing steel 54, (material) (depth)  
2" (size) if telescope see back.
  - (5) screen 3' 55' (length) (depth to top)  
1/4 slot Johnson S.S. (size) (material)
  - (6) pump 1/2 3 1/2 (HP) (yield gpm)  
elec rod pump (type power)
  - (7) electric log no (yes or no)
- (organization running log)


(8) how well bottom plugged  
flush point

DRILLERS REMARKS:

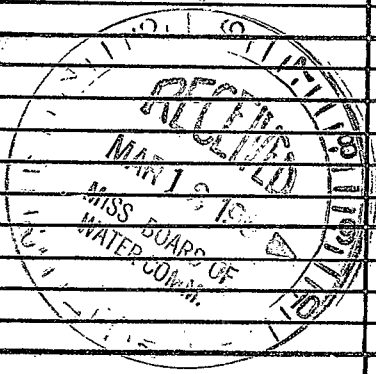

If well telescopes please sketch and show depths.

GROUND LEVEL

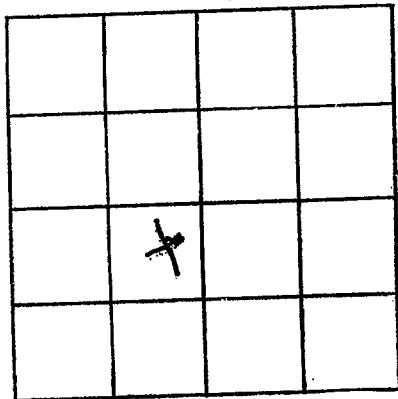

SECTION 6

Please indicate well location X.

ADDITIONAL INFORMATION

If more than one screen, show locations of each on sketch.