

WAYNE
H 85
3-68

MISSISSIPPI
BOARD OF WATER COMMISSIONERS
416 North State Street
Jackson, Mississippi 39201

WATER WELL DRILLERS LOG

March 16 1968 Porter Drilling & Log Wayne
date well completed firm name county well located

LANDOWNER: Buster Gordon

description of formations encountered

from to

Azalea Drive
Waynesboro Miss
(mailing address)

<u>red sand</u>	<u>0</u>	<u>5</u>
<u>red clay</u>	<u>5</u>	<u>14</u>
<u>blue chdk</u>	<u>14</u>	<u>19</u>
<u>rock strata</u>	<u>19</u>	<u>48</u>
<u>white chalk</u>	<u>48</u>	<u>76</u>
<u>sand & chalk</u>	<u>76</u>	<u>94</u>
<u>fine blue sand</u>	<u>94</u>	<u>104</u>
<u>stayed on chalk</u>		

WELL LOCATION:

sec. 27 T. 9 N R. 7 E
S W
3 1/2 miles NW of Waynesboro
(distance) (direction) (nearest town)

WELL PURPOSE: home
(home, irrigation, municipal, industrial)

WELL COMPLETION DATA:

- (1) diameter (inches) 2"
- (2) total depth (feet) 104'
- (3) static water level (feet) 57' below top of ground.
- (4) casing steel 84'
(material) (depth)
2" if telescope see back.
(size)
- (5) screen 12' 92'
(length) (depth to top)
1 1/4" 90 ga brass jacket
(size) (material)
- (6) pump 1 8
(HP) (yield gpm)
elec.
(type power)
- (7) electric log no
(yes or no)

(organization running log)

(8) how well bottom plugged flush gravel


DRILLERS REMARKS:

APR 26 1968

MISS. Bd. OF
WATER COMM.

If well telescopes please sketch and show depths.

GROUND LEVEL

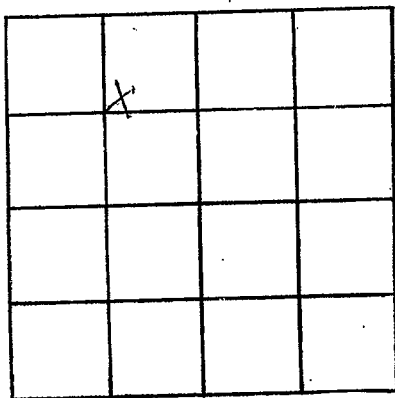

SECTION 27

Please indicate well location X.

ADDITIONAL INFORMATION

If more than one screen, show locations of each on sketch.