

WAYNE MISSISSIPPI BOARD OF WATER COMMISSIONERS

H 23 87
9-21-64

WATER WELL DRILLERS LOG

Date: Sept 21, 1964, Driller: Porter Drilling & Supply Co. Wayne
3P (Name)


(1) Owner of Land: Noland Clark
(Name)
Waynesboro Miss
(Address)
(2) Location: SW 1/4, SE 1/4, Sec 36 T 9 R 7
1 miles north of Waynesboro
(distance) (direction) (Nearest Town)
(3) Topography: hilly
(Hilly) (Flat) (Level)
(4) Purpose of Well: domestic
(Domestic Irrigation
Municipal, Industrial, Other)

Description & Color of Materials Sand, Clay, Red Clay, Shell, etc.	Thick- ness Feet	Depth Feet
<u>red clay</u>	<u>8</u>	<u>8</u>
<u>rock strata</u>	<u>12</u>	<u>20</u>
<u>blue chalk</u>	<u>2</u>	<u>22</u>
<u>grey sand</u>	<u>16</u>	<u>38</u>
<u>stratum in blue chalk</u>		

Information upon completion of well:

(1) Diameter 2" inches.
(2) Total Depth 38' feet.
(3) Water Level 23' feet below top of ground.
(4) Cased to 32', Size 2"
(5) Screen: Size 1/4", Length 6'
60 ga
(6) Were any formations sealed against pollution?
no

yes, no.
If YES depth of formation: _____
Why: _____
Drillers Remarks: _____

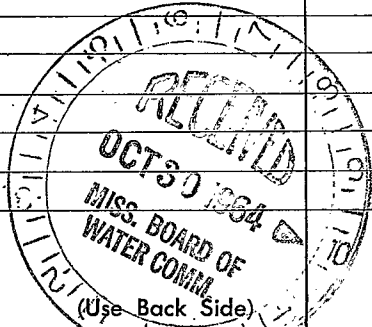

Well No.

