

Wayne
H93
7-68

MISSISSIPPI
BOARD OF WATER COMMISSIONERS
416 North State Street
Jackson, Mississippi 39201

WATER WELL DRILLERS LOG

July 8 1968 Porter Drilling & Pump Wayne
date well completed firm name county well located

LANDOWNER: George Grainwater

| Description of formations encountered | from | to |
|---------------------------------------|-----------------|-----------|
| | <u>red clay</u> | <u>0</u> |
| <u>sand</u> | <u>12</u> | <u>34</u> |

2044 Miss
Wayne
(mailing address)

WELL LOCATION:
sec. 14 T. 9 N. R. 7 E. S. 3 W.
5 miles N of Waynesboro
(distance) (direction) (nearest town)

WELL PURPOSE: Home
(home, irrigation, municipal, industrial)


WELL COMPLETION DATA:

- (1) diameter (inches) 2'
- (2) total depth (feet) 34'
- (3) static water level (feet) 22 below top of ground.
- (4) casing steel, 29' (material) (depth)
2' (size) if telescope see back.
- (5) screen 5', 29' (length) (depth to top)
1/4" slot Johnson S.S. (size) (material)
- (6) pump 3, 10 (HP) (yield gpm)
elec (type power)
- (7) electric log no (yes or no)

(organization running log)


(8) how well bottom plugged flush point

DRILLERS REMARKS: screen
screwed on casing

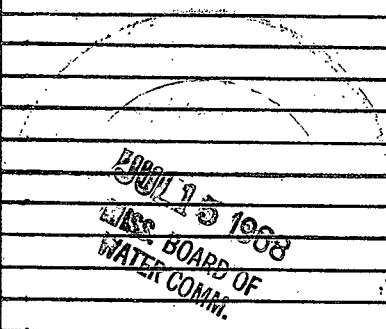

If well telescopes please sketch and show depths.

GROUND LEVEL

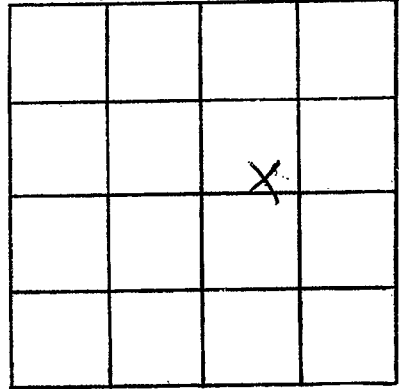

SECTION 14

Please indicate well location X.

ADDITIONAL INFORMATION

If more than one screen,
show locations of each on sketch.