

Wayne  
H94  
6-68

MISSISSIPPI  
BOARD OF WATER COMMISSIONERS  
416 North State Street  
Jackson, Mississippi 39201

WATER WELL DRILLERS LOG

June 29 1968 Porter Drilling & Log Wayne  
date well completed firm name county well located

LANDOWNER: Fred West

| description of formations encountered | from | to |
|---------------------------------------|------|----|
| red clay                              | 0    | 10 |
| red sand                              | 10   | 53 |
| thin rock                             |      | 53 |
| stopped on chalk                      |      |    |

At 1 Waynesboro Miss  
(mailing address)

WELL LOCATION:

sec 18 T 9 N R 7 E  
S W  
7 miles NW of Waynesboro  
(distance) (direction) (nearest town)

WELL PURPOSE: Home  
(home, irrigation, municipal, industrial)

WELL COMPLETION DATA:


- (1) diameter (inches) 2"
- (2) total depth (feet) 53'
- (3) static water level (feet) 34' below top of ground.
- (4) casing steel 48' (material) (depth)  
2" (size) if telescope see back.
- (5) screen 5' 48' (length) (depth to top)  
1 1/4" slot Johnson S.S. (size) (material)
- (6) pump 1 10 (HP) (yield gpm)  
elec. (type power)
- (7) electric log no (yes or no)

(organization running log)

(8) how well bottom plugged  
flush point


DRILLERS REMARKS:

42' 1 1/4" drop pipe  
screen screwed on Cas.

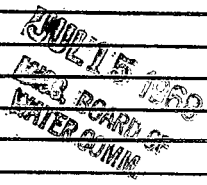

If well telescopes please  
sketch and show depths.

GROUND LEVEL

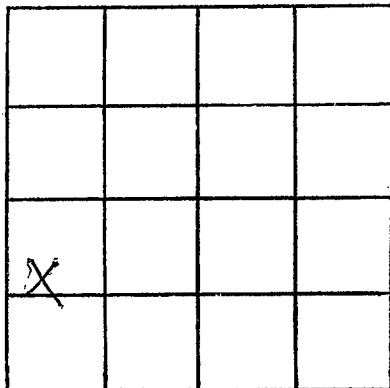

SECTION 18

Please indicate well location X.

ADDITIONAL INFORMATION

If more than one screen,  
show locations of each on sketch.