

Wayne  
H 95  
6-68

MISSISSIPPI  
BOARD OF WATER COMMISSIONERS  
416 North State Street  
Jackson, Mississippi 39201

WATER WELL DRILLERS LOG

June 22 1968 date well completed  
Porter Drilling Co. firm name  
Wayne county well located

LANDOWNER: Claude Brown

description of formations encountered	from	to
sandy red clay	0	20
mostly cherty	20	85
sand & some peag sand	85	132
slight white shell in sand		

Port 1 Waynesboro Miss (mailing address)

WELL LOCATION:  
sec. 20 T. 9 N R. 7 E S W  
4 miles NW of Waynesboro  
(distance) (direction) (nearest town)

WELL PURPOSE: home  
(home, irrigation, municipal, industrial)


WELL COMPLETION DATA:

- (1) diameter (inches) 2"
- (2) total depth (feet) 132'
- (3) static water level (feet) 100 <sup>below</sup>/<sub>above</sub> top of ground.
- (4) casing steel, 126', (material) (depth)  
2" (size) If telescope see back.
- (5) screen 5', 127' (length) (depth to top)  
1/4" 10 slot Johnson S.S. (size) (material)
- (6) pump 1/2 HP Prod 3 1/2 (HP) (yield gpm)  
elec. (type power)
- (7) electric log no (yes or no)

(organization running log)


(8) how well bottom plugged flush point

DRILLERS REMARKS:

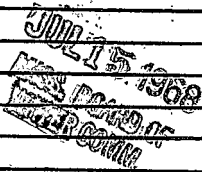

If well telescopes please  
sketch and show depths.

GROUND LEVEL

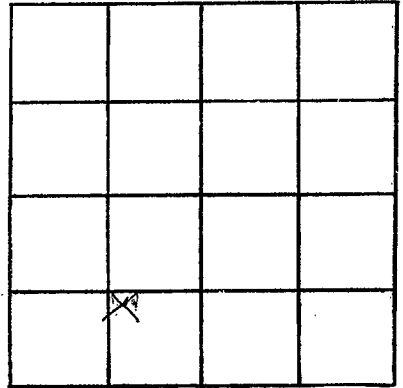

SECTION 20

Please indicate well location X.

ADDITIONAL INFORMATION

If more than one screen,  
show locations of each on sketch.