

Wayne  
H 97  
9-68

MISSISSIPPI  
BOARD OF WATER COMMISSIONERS  
416 North State Street  
Jackson, Mississippi 39201

CODED

WATER WELL DRILLERS LOG

Sept 9 1968 Porter Drilling Log Wayne  
date well completed firm name county well located

LANDOWNER: Clinton Walker  
Archie Walker

description of formations encountered	depth	
	from	to
<u>clay</u>	<u>0</u>	<u>7</u>
<u>sand</u>	<u>7</u>	<u>10</u>
<u>small stones</u>	<u>10</u>	<u>29</u>
<u>blue chalk</u>	<u>29</u>	<u>70</u>
<u>Meriburg limestone</u>	<u>70</u>	<u>125</u>

211 Waverly Drive  
(mailing address)

WELL LOCATION:  
sec 34 T 20 N R 7 E  
2 miles NW of Waynesboro  
(distance) (direction) (nearest town)

WELL PURPOSE:  
(home, irrigation, municipal, industrial)

WELL COMPLETION DATA:

(1) diameter (inches) 2"

(2) total depth (feet) 125'

(3) static water level (feet) 31' below top of ground.

(4) casing steel, 74'  
(material) (depth)  
2" if telescope see back.  
(size)

(5) screen none,  
(length) (depth to top)  
(size) (material)

(6) pump 1/2, 2  
(HP) (yield gpm)  
elec  
(type power)


(7) electric log yes  
(yes or no)  
(organization running log)

(8) how well bottom plugged  
open

DRILLERS REMARKS:


42' 1 1/2" casing pipe

CODED

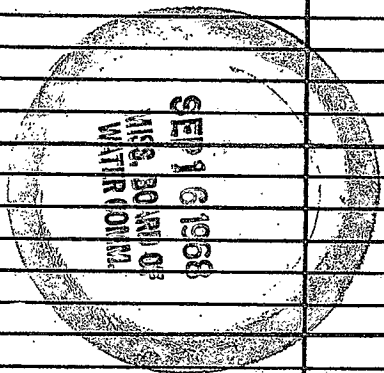

If well telescopes please sketch and show depths.

GROUND LEVEL

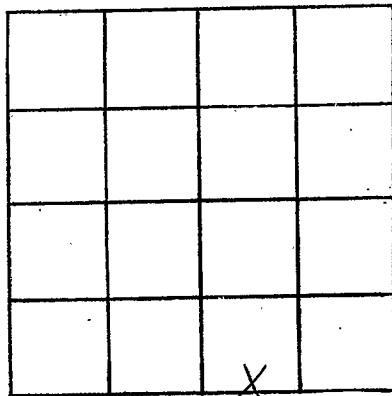

SECTION 34

Please indicate well location X.

ADDITIONAL INFORMATION

If more than one screen, show locations of each on sketch.