

MISSISSIPPI
BOARD OF WATER COMMISSIONERS
416 North State Street
Jackson, Mississippi 39201

WATER WELL DRILLERS LOG

CODED

Wayne
H98
7-68

July 20 1968 P. A. Dialling Co. Wayne
date well completed firm name county well located

LANDOWNER: Norm Lee Hough

description of formations encountered from to

Abraham Manness Lane Miss
(mailing address)

sandstone + sand
chert
sandstone
chert
sandstone
blue chert
blue chert
sandstone
fine sand
sand + chert
stopped on chert

WELL LOCATION:
sec 12 T 9 N R 7 E
S W
5 miles N of Waynesboro
(distance) (direction) (nearest town)


from	to
0	13
13	66
66	94
94	103
103	106
106	125
125	139
138	251
256	315
325	339
339	346
346	350
350	351
351	362

WELL PURPOSE: drinking water
(home, irrigation, municipal, industrial)

- WELL COMPLETION DATA:
- (1) diameter (inches) 2"
 - (2) total depth (feet) 362
 - (3) static water level (feet) 134 below above top of ground.
 - (4) casing steel 246'
(material) (depth)
2" If telescope see back.
(size)
 - (5) screen 17' 345
(length) (depth to top)
1/2" iron mesh 20ga
(size) (material)
 - (6) pump 3/4 HP 3 1/2
(HP) (yield gpm)
also
(type power)
 - (7) electric log no
(yes or no)
(organization running log)
 - (8) how well bottom plugged flush gravel

stopped at 136'


CODED

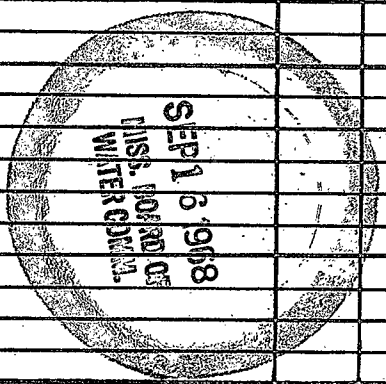

DRILLERS REMARKS:
134' 4" sandstone + chert
rest of well is sandstone

If well telescopes please sketch and show depths.

GROUND LEVEL

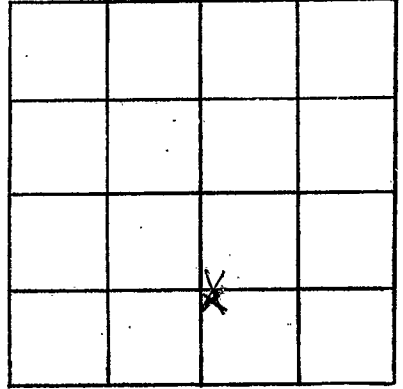

SECTION 12

Please indicate well location X.

ADDITIONAL INFORMATION

If more than one screen, show locations of each on sketch.