

MISSISSIPPI
BOARD OF WATER COMMISSIONERS
416 North State Street
Jackson, Mississippi 39201

INDEXED

WAYNE
H99
11-7-68

WATER WELL DRILLERS LOG

Nov 7 1968 Porter Drilling & Log Wayne
date well completed firm name county well located

LANDOWNER: Clinton Holland

description of formations encountered	from	to
<u>sectal</u>	<u>0</u>	<u>10</u>
<u>sectal fromy chalk</u>	<u>10</u>	<u>63</u>
<u>sectal soft chalk</u>		

101 Agricultural Miss.
(mailing address)

WELL LOCATION:
sec. 29 T 9 N R 7 E
S W
4 miles NW of Waynesboro
(distance) (direction) (nearest town)

WELL PURPOSE: Home
(home, irrigation, municipal, industrial)

WELL COMPLETION DATA:

(1) diameter (inches) 2"

(2) total depth (feet) 63'

(3) static water level (feet) 143' (below/above top of ground)

(4) casing steel 58'
(material) (depth)
2" If telescope see back.
(size)

(5) screen 5' 58'
(length) (depth to top)
1/4" bolt S.S.
(size) (material)

(6) pump 1/2 4
(HP) (yield gpm)
elec
(type power)

(7) electric log no
(yes or no)

(organization running log)

INDEXED

(8) how well bottom plugged
plugged


DRILLERS REMARKS:

NOV - 9 1968

MISS. BD. OF
WATER POLL.

If well telescopes please sketch and show depths.

GROUND LEVEL

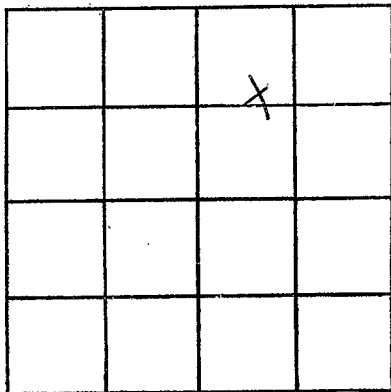

SECTION 29

Please indicate well location X.

ADDITIONAL INFORMATION

If more than one screen,
show locations of each on sketch.