

CODED

CODED

MISSISSIPPI  
BOARD OF WATER COMMISSIONERS  
416 North State Street  
Jackson, Mississippi 39201

WATER WELL DRILLERS LOG

Wayne  
H 100  
12-11-68

Dec 11, 1968 date well completed  
Porter Drilling & Log firm name  
Wayne county well located

LANDOWNER: Mrs. Chester  
Hudson

description of formations encountered  
from to

Box 4 Waynesboro, Miss  
(mailing address)

soft clay  
rock strata  
sandstone  
57 72

WELL LOCATION:  
sec. 36 T 9 N R 7 E  
1 miles N of Waynesboro  
(distance) (direction) (nearest town)

stagnant water  
still in sand

WELL PURPOSE: home  
(home, irrigation, municipal, industrial)

2' 1/4 log on screen

WELL COMPLETION DATA:

start into casing with

(1) diameter (inches) 2'

~~2' 1/4~~ cylinder

(2) total depth (feet) 72'

(3) static water level (feet) 62' below top of ground.

(4) casing steel 65' (material) (depth)

2" (size) if telescope see back.

(5) screen 6' 66' (length) (depth to top)

1 1/2 60 ga bronze gasket (size) (material)

(6) pump 1/2 3 1/2 (HP) (yield gpm)

elec. rod pump (type power)

(7) electric log no (yes or no)

(organization running log)

(8) how well bottom plugged  
flush joint


DRILLERS REMARKS:

FEB - 2 1969

MISS. Bd. OF  
WATER COMM.

If well telescopes please sketch and show depths.

GROUND LEVEL

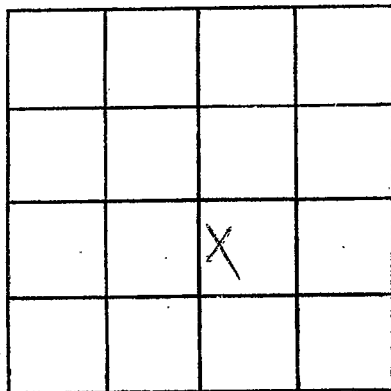

SECTION 36

Please indicate well location X.

ADDITIONAL INFORMATION

If more than one screen, show locations of each on sketch.