

RODED

CODED

MISSISSIPPI BOARD OF WATER COMMISSIONERS
416 North State Street
Jackson, Mississippi 39201

WATER WELL DRILLERS LOG

Wayne
#101
12-12-68

Dec 12 1968 date well completed
Porth Drilling & Log firm name
Wayne county well located

LANDOWNER: Jim O Connell
644 Haysboro Miss
(mailing address)

WELL LOCATION:
sec 36 T 9 N R 7 E
S W
1 miles N of Haysboro
(distance) (direction) (nearest town)

WELL PURPOSE: home
(home, irrigation, municipal, industrial)

WELL COMPLETION DATA:

- (1) diameter (inches) 2"
- (2) total depth (feet) 140'
- (3) static water level (feet) 81' below above top of ground.
- (4) casing steel 111' (material) (depth)
2" if telescope see back.
(size)
- (5) screen none used (length) (depth to top)
(size) (material)
- (6) pump 2 9 (HP) (yield gpm)
elec. (type power)
- (7) electric log no (yes or no)
(organization running log)
- (8) how well bottom plugged none

description of fomations encountered	from	to
red clay	0	8
sand	8	18
chalk	12	34
rock	34	39
blue chalk	39	50
rock stratus	50	71
sand & chalk	71	76
fine calcareous sand	76	100
blue chalk	100	109
Yachsburg rock	109	140

RODED


FEB - 3 1969

MISS. DE. OF WATER COMMISSIONERS

DRILLERS REMARKS:

If well telescopes please sketch and show depths.

GROUND LEVEL

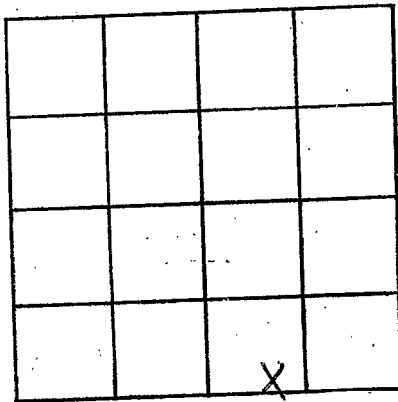

SECTION 36

Please indicate well location X.

ADDITIONAL INFORMATION

If more than one screen, show locations of each on sketch.