

Wayne  
 # 103  
 12-26-68

MISSISSIPPI  
 BOARD OF WATER COMMISSIONERS  
 416 North State Street  
 Jackson, Mississippi 39201

CODED  
 CODED

WATER WELL DRILLERS LOG

12-26-1968 Roy V West Wayne  
 date well completed firm name county well located

LANDOWNER	Description of formations encountered	from	to
<u>Jimmy Lee Goudy</u>	<u>Red clay</u>	<u>0</u>	<u>15</u>
<u>Rt 4</u>	<u>Sandy clay</u>	<u>15</u>	<u>35</u>
<u>Waynesboro Miss</u>	<u>Sand</u>	<u>35</u>	<u>60</u>
(mailing address)	<u>sandy clay</u>	<u>60</u>	<u>85</u>
	<u>Sand</u>	<u>85</u>	<u>123</u>

WELL LOCATION:  
 sec. 1 T 9 N R 7 E  
8 miles SW of Waynesboro  
 (distance) (direction) (nearest town)

WELL PURPOSE: home  
 (home, irrigation, municipal, industrial)

- WELL COMPLETION DATA:
- (1) diameter (inches) 2
  - (2) total depth (feet) 123
  - (3) static water level (feet) 90 below above top of ground.
  - (4) casing Galv 118  
 (material) (depth)  
 (size) if telescope see back.
  - (5) screen 5 118  
 (length) (depth to top)  
1/4 St Steel  
 (size) (material)
  - (6) pump 1 5  
 (HP) (yield gpm)  
Rea  
 (type power)
  - (7) electric log no  
 (yes or no)

(organization running log)  
 (8) how well bottom plugged Washed

CODED


JAN 24 1969

MISS. BD. OF WATER COMMISSIONERS

DRILLERS REMARKS:

If well telescopes please sketch and show depths.

GROUND LEVEL

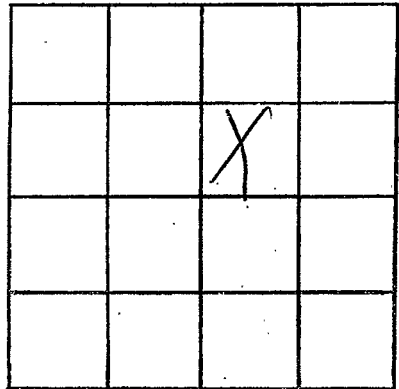

SECTION 1

Please indicate well location X.

ADDITIONAL INFORMATION

If more than one screen, show locations of each on sketch.