

Wayne
H 104
L-B-69

MISSISSIPPI
BOARD OF WATER COMMISSIONERS
416 North State Street
Jackson, Mississippi 39201

CODED

WATER WELL DRILLERS LOG

1-13 1969 Roy West Wayne
date well completed from name county well located

LANDOWNER Baptist Church Rt 4 Waynesboro (mailing address)	description of formations encountered	from	to
		Sandy Clay	0
	Sand	15	40
	Sandy clay	40	60
	Sand	60	87
	Clay	87	95
	Sand	95	131

WELL LOCATION:
sec. 12 T 9 N R 7 E
7 miles S of Waynesboro
(distance) (direction) (nearest town)

WELL PURPOSE: home
(home, irrigation, municipal, industrial)

- WELL COMPLETION DATA:
- (1) diameter (inches) 2
 - (2) total depth (feet) 131
 - (3) static water level (feet) 118 below top of ground.
 - (4) casing Galv 126 (material) (depth)
 - (size) if telescope see back.
 - (5) screen 5 126 (length) (depth to top)
 - 1/2 St. Steel (size) (material)
 - (6) pump 1 5 (HP) (yield gpm)
 - Rea (type power)
 - (7) electric log NO (yes or no)
 - (organization running log)
 - (8) how well bottom plugged Washwater


CODED

MISS. BD. OF WATER COMMISSIONERS

DRILLERS REMARKS:

If well telescopes please sketch and show depths.

GROUND LEVEL

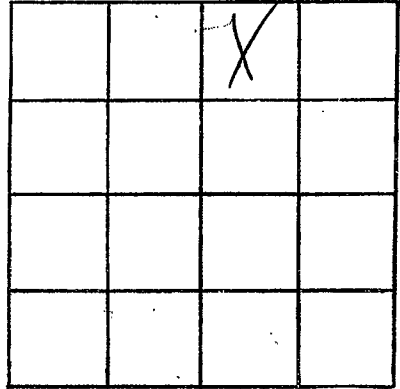

SECTION 12

Please indicate well location X.

ADDITIONAL INFORMATION

If more than one screen,
show locations of each on sketch.