

WAYNE
H 105
1-31-69

MISSISSIPPI
BOARD OF WATER COMMISSIONERS
416 North State Street
Jackson, Mississippi 39201

CODED

CODED

WATER WELL DRILLERS LOG

Jan 31, 1969 date well completed
Boyle Drilling Co. firm name
Wayne county well located

LANDOWNER: G. B. Roberts
311 Wagnersboro Miss
(mailing address)

description of formations encountered	from	to
red clay	0	10
small	10	70
red chalk & sand	70	95
blue chalk	95	116
Wagnersboro limestone	116	132

WELL LOCATION:
sec. 8 T 9 N R 7 E
7 miles NW of Wagnersboro
(distance) (direction) (nearest town)

WELL PURPOSE: Home
(home, irrigation, municipal, industrial)

lost circulation 3' water

WELL COMPLETION DATA:

(1) diameter (inches) 4"

(2) total depth (feet) 132'

(3) static water level (feet) 111' below top of ground.

(4) casing steel 116' (material) (depth)
4" (size) if telescope see back.

(5) screen wire mesh (length) (depth to top)
(size) (material)

(6) pump 1 (HP) 18 (yield gpm)
elec. (type power)

(7) electric log no (yes or no)
(organization running log)

(8) how well bottom plugged open end


DRILLERS REMARKS:

CODED

FEB 7 1969
MISS. DIV. OF
WATER RESOURCES

If well telescopes please sketch and show depths.

GROUND LEVEL

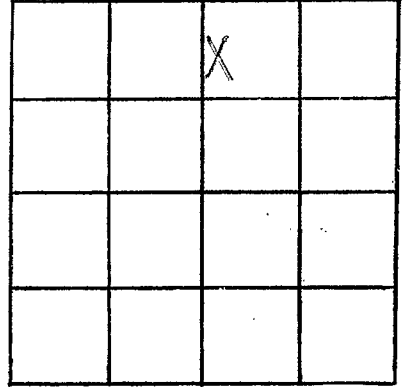

SECTION 2

Please indicate well location X.

ADDITIONAL INFORMATION

If more than one screen, show locations of each on sketch.