

Wayne
H 100
2-21-69

MISSISSIPPI
BOARD OF WATER COMMISSIONERS
416 North State Street
Jackson, Mississippi 39201

CODED

WATER WELL DRILLERS LOG

2-21-69 date well completed 1969 Roy Vurst firm name Wayne county well located

LANDOWNER: Oscar Howard
RT 4 Waynesboro
(mailing address)

WELL LOCATION:
sec. 12 T 9 N R 7 E
S W
7 miles NE Waynesboro of (distance) (direction) (nearest town)

WELL PURPOSE:
(home, irrigation, municipal, industrial)

WELL COMPLETION DATA:
(1) diameter (inches) 2
(2) total depth (feet) 378
(3) static water level (feet) 170 below top of ground.
(4) casing Galv 262 (material) (depth)
(size) if telescope see back.
(5) screen 15 363 (length) (depth to top)
(size) St Steel (material)
(6) pump 2 3 (HP) (yield gpm)
REA (type power)
(7) electric log No (yes or no)

description of formations encountered	from to	
clay	0	10
sand	10	30
sandy clay	30	60
sand	60	90
coarse sand	90	105
sandy clay	105	120
blue clay	120	175
rock	175	180
blue clay	180	240
rock and clay	240	320
blue clay	320	360
sand	360	378

(organization running log)


(8) how well bottom plugged wash water

DRILLERS REMARKS:

FEB 26 1969
MISS. DIV. OF
WATER CONTROL

If well telescopes please sketch and show depths.

GROUND LEVEL

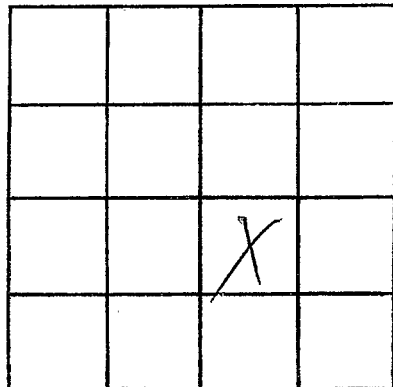

SECTION 12

Please indicate well location X.

ADDITIONAL INFORMATION

If more than one screen, show locations of each on sketch.