

CODED

ETN 7/28/69

Red 10/3/69

WAYNE

H 108

7-2-69

MISSISSIPPI BOARD OF WATER COMMISSIONERS 416 North State Street Jackson, Mississippi 39201

WATER WELL DRILLERS LOG

7-2 1969 date well completed Roger Mull Service firm name Wayne county well located

LANDOWNER:

Wilma Harmon

Route - Waynesboro - Miss (mailing address)

description of formations encountered

Surface sand 15' Sand & gravel 30' 70'

from to

0 15 15 30 30 70

WELL LOCATION:

sec 20 T 10 N R 6 E 5 miles N of Waynesboro (distance) (direction) (nearest town)

WELL PURPOSE: Home (home, irrigation, municipal, industrial)

WELL COMPLETION DATA:

- (1) diameter (inches) 2 (2) total depth (feet) 70 (3) static water level (feet) 20 below top of ground.

(4) casing Galv 60 (material) (depth)

(size) If telescope see back.

(5) screen 5 60 (length) (depth to top)

2 Brass (size) (material)

(6) pump 1 10 (HP) (yield gpm)


220 (type power)

(7) electric log (yes or no)

(organization running log)


(8) how well bottom plugged P.W.V

DRILLERS REMARKS:

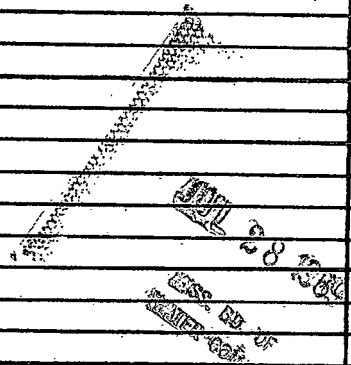

If well telescopes please sketch and show depths.

GROUND LEVEL

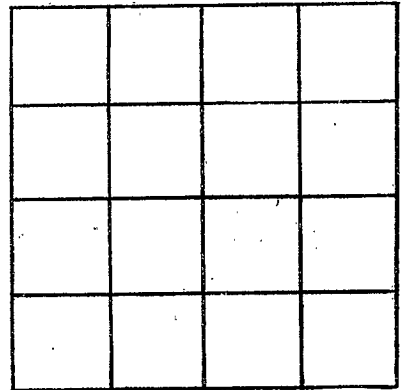

SECTION _____

Please indicate well location X.

ADDITIONAL INFORMATION

If more than one screen, show locations of each on sketch.