

WAYNE

H 109

7-17-69

MISSISSIPPI
 BOARD OF WATER COMMISSIONERS
 416 North State Street
 Jackson, Mississippi 39201

CODED

CODED

WATER WELL DRILLERS LOG

July 17 1969 Route 600, Wiggins, Wayne
 date well completed firm name county well located

LANDOWNER: Korring
Acme water
244 Wainwright, Miss
 (mailing address)

WELL LOCATION:
 sec 13 T 90 N R 7 E
5 miles N of Wainwright
 (distance) (direction) (nearest town)

WELL PURPOSE: home
 (home, irrigation, municipal, industrial)

WELL COMPLETION DATA:

(1) diameter (inches) 2"

(2) total depth (feet) 39'

(3) static water level (feet) 21' below above top of ground.

(4) casing stal 28'
 (material) (depth)
2" if telescope see back.
 (size)

(5) screen 11' 28'
 (length) (depth to top)
1 1/2" 20 ga S.S.
 (size) (material)

(6) pump 3 1/2 7
 (HP) (yield gpm)
elec.
 (type power)

(7) electric log no
 (yes or no)

(organization running log)


(8) how well bottom plugged:
filled with cement

description of formations encountered	from	to
<u>red sandy clay</u>	<u>0</u>	<u>6</u>
<u>sand</u>	<u>6</u>	<u>16</u>
<u>blue chalk</u>	<u>16</u>	<u>17</u>
<u>fine blue sand</u>	<u>17</u>	<u>21</u>
<u>stayed on chalk</u>	<u>21</u>	<u>40</u>
<u>11' 1/4 20 ga S.S. screen</u>		
<u>on end of cas & screen</u>		
<u>packed.</u>		
<u>26' 1/4 20 ga S.S. screen</u>		

DRILLERS REMARKS:

If well telescopes please sketch and show depths.

GROUND LEVEL

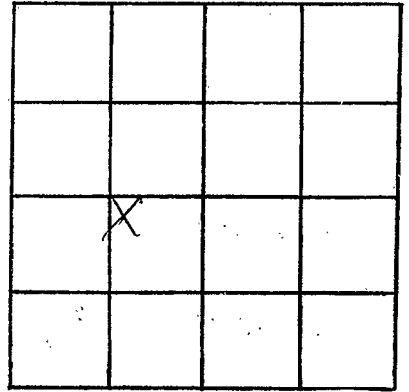

SECTION 13

Please indicate well location X.

ADDITIONAL INFORMATION

If more than one screen,
show locations of each on sketch.