

Wayne  
H 111  
9-3-69

MISSISSIPPI  
BOARD OF WATER COMMISSIONERS  
416 North State Street  
Jackson, Mississippi 39201

CODED  
CODED

WATER WELL DRILLERS LOG


Sept 3 1969 date well completed  
Port Drilling firm name  
Wayne county well located

LANDOWNER	description of formations encountered	from	to
Rt 4 Magneshorn Min (mailing address)	red clay sand chalk & sand fine blue sand x chalk	0 3 10 28	3 10 28 41
WELL LOCATION: sec 14 T 7 N S R 7 E W 5 miles N of Magneshorn (distance) (direction) (nearest town)	stop on chalk		
WELL PURPOSE: Home (home, irrigation, municipal, industrial)	12' 1 1/4' 80 gpm screen		
WELL COMPLETION DATA:	screened on end of casing		
(1) diameter (inches) 2"	x sand packed		
(2) total depth (feet) 41			
(3) static water level (feet) 15 (below/above top of ground)			
(4) casing steel 29' (material) (depth) 2" if telescope see back (size)			
(5) screen 12' 29' (length) (depth to top) 1 1/4" 80 gpm S.S. (size) (material)			
(6) pump 3/4 7 (HP) (yield gpm) elec (type power)			
(7) electric log no (yes or no)			
(organization running log)			
(8) how well bottom plugged flush ground			
DRILLERS REMARKS:			

SEP 24 1969  
en O  
COM

If well telescopes please sketch and show depths.

GROUND LEVEL

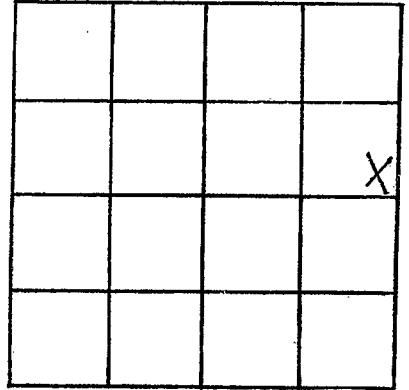

SECTION 14

Please indicate well location X.

ADDITIONAL INFORMATION

If more than one screen,  
show locations of each on sketch.