

MISSISSIPPI
BOARD OF WATER COMMISSIONERS
416 North State Street
Jackson, Mississippi 39201

CODED
CODED

WATER WELL DRILLERS LOG

Wayne
H 112
9-18-69

Sept 8 1969 Docter Drilling & Sup. Wayne
date well completed firm name county well located

LANDOWNER: <u>William Jones</u>	description of formations encountered	from	to
<u>Box 1 Haysboro Miss</u> (mailing address)	<u>red clay</u>	<u>0</u>	<u>13</u>
WELL LOCATION: sec <u>33</u> T <u>2</u> N R <u>7</u> E <u>3</u> miles <u>NW</u> of <u>Haysboro</u> (distance) (direction) (nearest town)	<u>sand</u>	<u>13</u>	<u>19</u>
WELL PURPOSE: <u>domo</u> (home, irrigation, municipal, industrial)	<u>Chalk + sand</u>	<u>19</u>	<u>34</u>
WELL COMPLETION DATA:	<u>sand</u>	<u>34</u>	<u>47</u>
(1) diameter (inches) <u>2"</u>	<u>stained white</u>		
(2) total depth (feet) <u>41</u>	<u>sheet in sand</u>		
(3) static water level (feet) <u>28</u> below above top of ground.			
(4) casing <u>stal</u> <u>35 1/2'</u> (material) (depth)			
<u>2'</u> if telescope see back. (size)			
(5) screen <u>6'</u> <u>35'</u> (length) (depth to top)			
<u>1 1/2"</u> <u>80 ga S.S.</u> (size) (material)			
(6) pump <u>1/2</u> <u>7</u> (HP) (yield gpm)			
<u>elec.</u> (type power)			
(7) electric log <u>no</u> (yes or no)			
(organization running log)			
(8) how well bottom plugged <u>flush pump</u>			
DRILLERS REMARKS:			


6' 1 1/4" 80 ga S.S. with
1' 1 1/4" long pipe
in with packer

SEP 24 1969

MISS. BU. OF
WATER CONSERV.

If well telescopes please sketch and show depths.

GROUND LEVEL

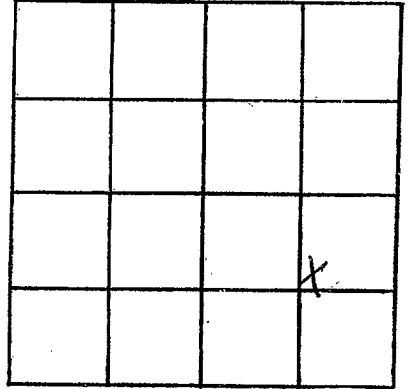

SECTION 33

Please indicate well location X.

ADDITIONAL INFORMATION

If more than one screen,
show locations of each on sketch.