

CODED

**MISSISSIPPI
BOARD OF WATER COMMISSIONERS**
416 North State Street
Jackson, Mississippi 39201

Wayne
H 114
2-13-70

WATER WELL DRILLERS LOG

Feb. 13 1970 Boata Drilling Co. Wayne
date well completed firm name county well located

LANDOWNER: <u>Robert Gray</u>	description of formations encountered	from	to
<u>214 Wagneshore, Miss</u> (mailing address)	<u>well sand</u>	<u>0</u>	<u>20</u>
	<u>chalk</u>	<u>20</u>	<u>72</u>
	<u>cut coarse dry sand</u>	<u>72</u>	<u>111</u>
	<u>chalk</u>	<u>111</u>	<u>116</u>
	<u>sand</u>	<u>116</u>	<u>122</u>
	<u>blue chalk</u>	<u>122</u>	<u>145</u>
	<u>rock</u>	<u>145</u>	<u>150</u>
	<u>blue chalk</u>	<u>150</u>	<u>262</u>
	<u>rock strata</u>	<u>262</u>	<u>270</u>
	<u>blue chalk</u>	<u>270</u>	<u>332</u>
	<u>rock strata</u>	<u>332</u>	<u>332</u>
	<u>sandstone</u>	<u>332</u>	<u>361</u>
	<u>chalk to rock</u>	<u>361</u>	<u>365</u>
	<u>sandstone</u>	<u>365</u>	<u>367</u>
	<u>chalk</u>	<u>367</u>	<u>369</u>
	<u>17' 1/4 20 ga ss rock</u>		
	<u>8' 1/4 20 ga ss rock</u>		
	<u>with packer, cyl. at</u>		
	<u>at 228' with packer</u>		
	<u>below to help level</u>		
	<u>etc reduced at 347</u>		
	<u>with 3/8" basket on</u>		
	<u>end of casing cement</u>		
	<u>into rock</u>		

WELL LOCATION:
sec 12 T 9 N R 7 E
6 miles N of Wagneshore
(distance) (direction) (nearest town)

WELL PURPOSE: home
(home, irrigation, municipal, industrial)

WELL COMPLETION DATA:


- (1) diameter (inches) 2"
- (2) total depth (feet) 369'
- (3) static water level (feet) 180 (below/above top of ground)
- (4) casing 2" (material) 349' (depth)
2" if telescope see back. (size)
- (5) screen 17' (length) 352 (depth to top)
1 1/2" (size) 30 ga S.S (material)
- (6) pump 3/4 hp (HP) 3 1/2 (yield gpm)
elec. (type power)
- (7) electric log no (yes or no)
(organization running log)
- (8) how well bottom plugged? flush ground

DRILLERS REMARKS:

FEB 24 1970

If well telescopes please sketch and show depths.

GROUND LEVEL

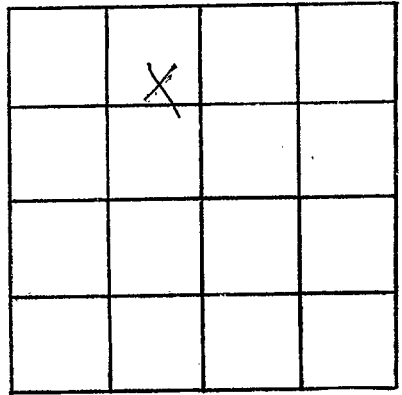

SECTION 12

Please indicate well location X.

ADDITIONAL INFORMATION

If more than one screen,
show locations of each on sketch.