

Wayne  
H 115  
3-19-70

MISSISSIPPI  
BOARD OF WATER COMMISSIONERS  
416 North State Street  
Jackson, Mississippi 39201

**CODED**

WATER WELL DRILLERS LOG

March 18 1970 Porter Drilling & Log Wayne  
date well completed firm name county well located

LANDOWNER: Jeanette Cookley description of formations encountered from to  
0 16  
16 75  
red clay  
sand  
stagnant m. shells  
0 16  
16 75

WELL LOCATION:  
sec. 7 T. 9 N. R. 7 E.  
7 miles NW of Wapadosa  
(distance) (direction) (nearest town)

WELL PURPOSE: home  
(home, irrigation, municipal, industrial)

- WELL COMPLETION DATA:
- (1) diameter (inches) 2"
  - (2) total depth (feet) 74'
  - (3) static water level (feet) 56' below above top of ground.
  - (4) casing steel 69 1/2'  
(material) (depth)  
2" if telescope see back.  
(size)
  - (5) screen 5' 69'  
(length) (depth to top)  
1 1/2" galv SS  
(size) (material)
  - (6) pump 1 7 1/2  
(HP) (yield gpm)  
elec  
(type power)
  - (7) electric log no  
(yes or no)
  - (organization running log)
  - (8) how well bottom plugged: flush ground

**CODED**


APR 17 1970

DRILLERS REMARKS:

MISS. BD. OF  
WATER COMM.

If well telescopes please sketch and show depths.

GROUND LEVEL

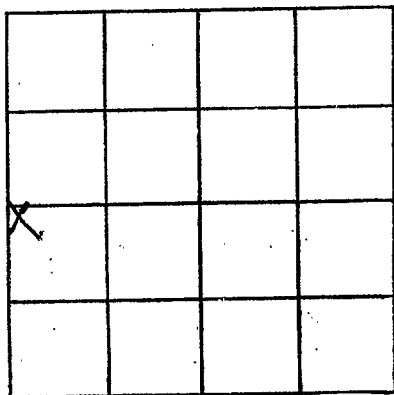

SECTION 7

Please indicate well location X.

ADDITIONAL INFORMATION

If more than one screen,  
show locations of each on sketch.