

Wayne  
H 716  
4-70

MISSISSIPPI  
BOARD OF WATER COMMISSIONERS  
416 North State Street  
Jackson, Mississippi 39201

CODED

WATER WELL DRILLERS LOG

April 1970 Reeplee Drilling Co Wayne  
date well completed firm name county well located

LANDOWNER: Billy Joe Evans

description of formations encountered	from	to
<u>yellow sandy clay</u>	<u>0</u>	<u>26</u>
<u>Blue clay</u>	<u>26</u>	<u>43</u>
<u>Blue Clay &amp; lime</u>	<u>43</u>	<u>65</u>
<u>Loam &amp; Finerock</u>	<u>65</u>	<u>82</u>
<u>White sand &amp; small shale streak</u>	<u>82</u>	<u>111</u>

#4  
Waynesboro, Miss  
(mailing address)

WELL LOCATION:  
sec 25 T 90 S R 7 E  
3 miles N of Waynesboro  
(distance) (direction) (nearest town)

WELL PURPOSE: HOME  
(home, irrigation, municipal, industrial)

WELL COMPLETION DATA:

- (1) diameter (inches) 2"
- (2) total depth (feet) 111'
- (3) static water level (feet) 63 below above top of ground.
- (4) casing Galv. 105'  
(material) (depth)  
2"  
(size) if telescope see back.
- (5) screen 6' 105'  
(length) (depth to top)  
2" BRASS  
(size) (material)
- (6) pump 1 2  
(HP) (yield gpm)  
electric  
(type power)
- (7) electric log no  
(yes or no)

(organization running log)

(8) how well bottom plugged Back Wash Valve

DRILLERS REMARKS:

CODED


CODED

APR 28 1970

MISS. BD. OF  
WATER COMM

If well telescopes please sketch and show depths.

GROUND LEVEL

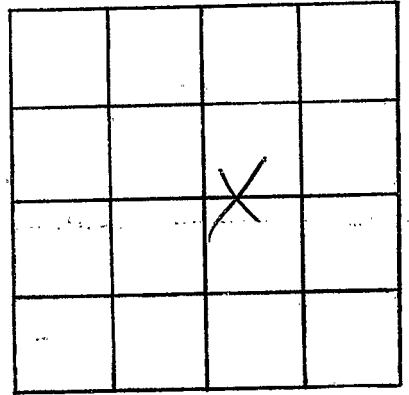

SECTION 25

Please indicate well location X.

ADDITIONAL INFORMATION

If more than one screen, show locations of each on sketch.