

Wayne Co
H 117
4-17-70

MISSISSIPPI
BOARD OF WATER COMMISSIONERS
416 North State Street
Jackson, Mississippi 39201

WATER WELL DRILLERS LOG

April 17 1970 Porter Drilling & Log Wayne
date well completed firm name county well located

LANDOWNER: <u>R. J. Henry</u>	description of formations encountered	from	to
<u>Atty Manselboro Miss</u> (mailing address)	<u>sand clay</u>	<u>0</u>	<u>23</u>
	<u>red chalk</u>	<u>23</u>	<u>38</u>
	<u>blue chalk</u>	<u>38</u>	<u>42</u>
	<u>red chalk</u>	<u>42</u>	<u>55</u>
	<u>sand marl to some</u>	<u>55</u>	<u>75</u>
	<u>fine sand</u>	<u>75</u>	<u>77</u>
	<u>chalk</u>	<u>77</u>	<u>78</u>
	<u>sand</u>	<u>78</u>	<u>117</u>
	<u>shaded white steel</u>		
	<u>in sand. 3'</u>		
	<u>of sand turning red</u>		
	<u>5' 1/2' 2" black ss. water</u>		
	<u>8' 1/2" fine green sand in</u>		
	<u>will collapse</u>		
	<u>97' 1 1/4" drop pipe</u>		

LANDOWNER: R. J. Henry

description of formations encountered

from

to

Atty Manselboro Miss
(mailing address)

sand clay 0 23
red chalk 23 38
blue chalk 38 42
red chalk 42 55
sand marl to some 55 75
fine sand 75 77
chalk 77 78
sand 78 117

WELL LOCATION: 033

sec. 1 T. 9 N. R. 7 E. 8 miles N of Waynesboro
(distance) (direction) (nearest town)

WELL PURPOSE: Home
(home, irrigation, municipal, industrial)

WELL COMPLETION DATA:

- (1) diameter (inches) 2"
- (2) total depth (feet) 117'
- (3) static water level (feet) 94' (below/above top of ground)
- (4) casing (material) steel (depth) 105'
2" (size) if telescope see back.
- (5) screen (length) 5' (depth to top) 112'
1 1/4" (size) 3 salt S.S. (material)
- (6) pump 2 (HP) 12 (yield gpm)
elec (type power)
- (7) electric log no (yes or no)
(organization running log)
- (8) how well bottom plugged filled with sand

5' 1/2' 2" black ss. water
8' 1/2" fine green sand in
will collapse
97' 1 1/4" drop pipe


MAY 20 1970

MISC. NO. OF _____

DRILLERS REMARKS:

If well telescopes please sketch and show depths.

GROUND LEVEL

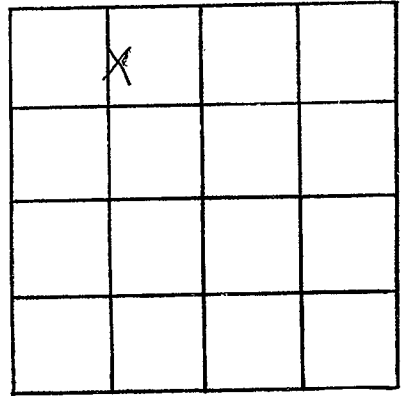

SECTION /

Please indicate well location X.

ADDITIONAL INFORMATION

If more than one screen,
show locations of each on sketch.