

Wayne
H 120
5-9-70

MISSISSIPPI
BOARD OF WATER COMMISSIONERS
416 North State Street
Jackson, Mississippi 39201

WATER WELL DRILLERS LOG

May 9 1970 *Boyle Drilling Co* Wayne
date well completed firm name county well located

LANDOWNER: *Walter Norman*
1005 Court St.
Tharshboro, Miss
(mailing address) 033

WELL LOCATION:
sec 27 T 9 N R 7 E
2 miles NW *Tharshboro*
(distance) (direction) of (nearest town)

WELL PURPOSE:
(home, irrigation, municipal, industrial)

WELL COMPLETION DATA:

(1) diameter (inches) 2

(2) total depth (feet) 450

(3) static water level (feet) small flow below top of ground.

(4) casing steel 4.65 (material) (depth)

2 (size) if telescope see back.

(5) screen none used (length) (depth to top)

(size) (material)

(6) pump none used 3 1/2 (HP) (yield gpm)

(type power)

(7) electric log no (yes or no)

(organization running log)

(8) how well bottom plugged: concrete


Description of formations encountered	from	to
clay to sand	0	15
Alachua sandstone	15	32
shale & thin chert	32	60
white chalk to some sand	60	72
blue chalk	72	291
rock strata	291	311
lime sand	311	315
chert chalk & rock strata	315	328
chert chalk	328	370
chalk, limestone & sand	370	393
thin chalk	393	404
thin rock		404
chalk & some sand	404	429
sand	429	435
chalk	435	450

DRILLERS REMARKS:
34" casing set to cut off casing

MAY 23 1970
SEALS, ETC. OF
WELLS MUST BE
MAINTAINED

If well telescopes please sketch and show depths.

GROUND LEVEL

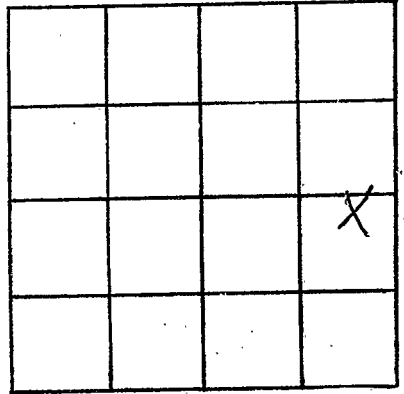

SECTION 27

Please indicate well location X.

ADDITIONAL INFORMATION

If more than one screen, show locations of each on sketch.