

Wayne
H 121
5-6-70

MISSISSIPPI
BOARD OF WATER COMMISSIONERS
416 North State Street
Jackson, Mississippi 39201

WATER WELL DRILLERS LOG

May 6 1970 W. Porter Drilling Co. Wayne
date well completed firm name county well located

LANDOWNER: Jerry Blakemore
Ray 636
Haysboro Miss
(mailing address) 033

WELL LOCATION:
sec 36 T 9 N R 7 E
1 miles N of Haysboro
(distance) (direction) (nearest town)

WELL PURPOSE: drinking
(home, irrigation, municipal, industrial)

WELL COMPLETION DATA:
(1) diameter (inches) 2"
(2) total depth (feet) 99'
(3) static water level (feet) 50 below above top of ground.
(4) casing steel 72
(material) (depth)
2" if telescope see back.
(size)
(5) screen none used
(length) (depth to top)
(size) (material)
(6) pump 3 1/2 8 1/2
(HP) (yield gpm)
elec
(type power)
(7) electric log no
(yes or no)
(organization running log)
(8) how well bottom plugged
open cement


description of formations encountered	from	to
red clay	0	8
blue chalk	8	16
rock strata	16	31
blue chalk	31	40
green sand	40	55
blue chalk	55	71
blackening, heavy sand	71	99
63' 1 1/2" deep pipe U.V.		

WAT 26 1070
L.A.S. 10/10/70
WAT 26 1070

DRILLERS REMARKS:

If well telescopes please sketch and show depths.

GROUND LEVEL

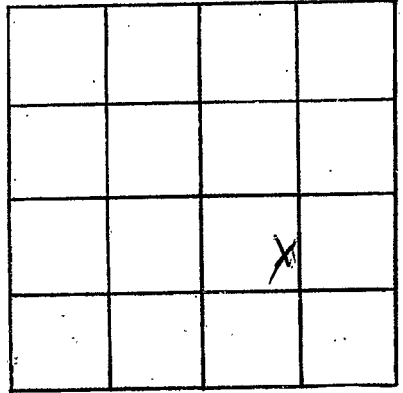

SECTION 36

Please indicate well location X.

ADDITIONAL INFORMATION

If more than one screen, show locations of each on sketch.