

MISSISSIPPI
BOARD OF WATER COMMISSIONERS
416 North State Street.
Jackson, Mississippi 39201

CODED

WATER WELL DRILLERS LOG

Way NE
H 123
7-16-70

July 16 1970 date well completed
Boyer Drilling firm name
Wayne county well located

LANDOWNER: J. B. Kenny

description of formations encountered	from	to
	red clay	0
sand & gravel	8	15
sand	15	27
white chalk	27	30

Box 4 Magneshoro Miss (mailing address)

WELL LOCATION:
sec. 12 T. 9 N. R. 7 S. 6 miles N of Magneshoro (distance) (direction) (nearest town)

stopped on chalk

WELL PURPOSE: none (home, irrigation, municipal, industrial)

- WELL COMPLETION DATA:
- (1) diameter (inches) 2"
 - (2) total depth (feet) 28'
 - (3) static water level (feet) 20' below top of ground
 - (4) casing steel 25' (material) (depth)
2" (size) if telescope see back.
 - (5) screen 2' 25' (length) (depth to top)
1/4" 8 slot S.S. (size) (material)
 - (6) pump 3/4 HP 7 (type power) (yield gpm)
 - (7) electric log elec. (yes or no)
- (organization running log)
- (8) how well bottom plugged flush joint

3' 1/4" 8 slot S.S.
reverted on end of case.
21' 1/4" 1" long pipe


CODED

AUG 13 1970

DRILLERS REMARKS:

If well telescopes please sketch and show depths.

GROUND LEVEL

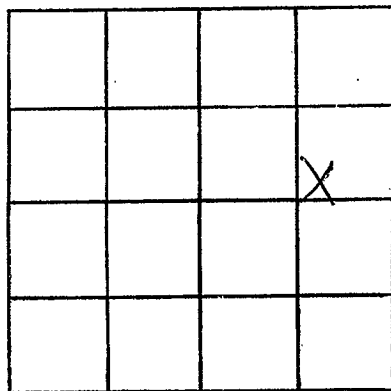

SECTION 12

Please indicate well location X.

ADDITIONAL INFORMATION

If more than one screen, show locations of each on sketch.