

MISSISSIPPI
BOARD OF WATER COMMISSIONERS
416 North State Street
Jackson, Mississippi 39201

CODED

WATER WELL DRILLERS LOG

Wayne
H 124
7-25-70

July 25, 1970 Porter Drilling & Log Wayne
date well completed firm name county well located

LANDOWNER: M. L. Brown
Jarvis Dr.
Waynesboro Miss
(mailing address)

WELL LOCATION:
sec. 1 T. 90 N. R. 7 E. S. 3
7 miles N of Waynesboro
(distance) (direction) (nearest town)

WELL PURPOSE: log parker
(home, irrigation, municipal, industrial)

| description of formations encountered | from | to |
|---------------------------------------|------|-----|
| well sand | 0 | 14 |
| Chalk | 14 | 38 |
| sand | 38 | 42 |
| Chalk | 42 | 51 |
| sand & chalk | 51 | 67 |
| limon sand | 67 | 102 |
| lime chalk and brown well sand | 102 | 115 |
| well sand | 115 | 123 |
| stop on chalk | | |

WELL COMPLETION DATA:

(1) diameter (inches) 2"

(2) total depth (feet) 123'

(3) static water level (feet) 88' (below/above top of ground)

(4) casing steel 115'
(material) (depth)
2" if telescope see back,
(size)

(5) screen 5' 118'
(length) (depth to top)
1 1/4" blast S.S.
(size) (material)

(6) pump 2 12
(HP) (yield gpm)
elec.
(type power)

(7) electric log no
(yes or no)

(organization running log)

5' 1 1/4" blast ss.
with 2' 1/4" lead pipe
& 2' 1/4" lag pipe
test in with cylinder
105' 1/4" dog pipe

CODED

(8) how well bottom plugged
flush cement


DRILLERS REMARKS:

AUG 13 1970

MISS. BD. OF
WATER COMM.

If well telescopes please sketch and show depths.

GROUND LEVEL

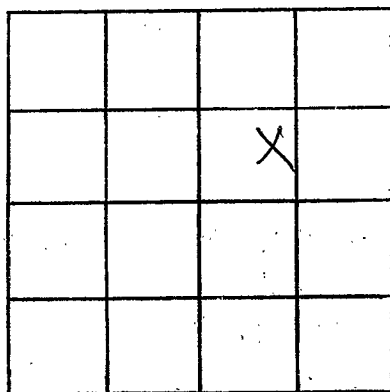

SECTION 1

Please indicate well location X.

ADDITIONAL INFORMATION

If more than one screen,
show locations of each on sketch.