

MISSISSIPPI
 BOARD OF WATER COMMISSIONERS
 416 North State Street
 Jackson, Mississippi 39201

CODED

WATER WELL DRILLERS LOG

WAYNE
H 125
7-31-70

July 31 1970 Porter Drilling Co Wayne
 date well completed firm name county well located

LANDOWNER Porter Drilling Co
At 4 Waynesboro Miss
 (mailing address)

description of formations encountered	from	to
Clay & chalk	0	11
with shales	11	17
Chalk & sand	17	26
sand	26	37
chalk	37	52
Wetshewey limestone	52	82

WELL LOCATION:
 sec 36 T 9 N R 7 E
 S W
1 miles N of Waynesboro
 (distance) (direction) (nearest town)

WELL PURPOSE: Home
 (home, irrigation, municipal, industrial)

- WELL COMPLETION DATA:
- (1) diameter (inches) 2"
 - (2) total depth (feet) 82'
 - (3) static water level (feet) 30 below top of ground.
 - (4) casing steel 55'
 (material) (depth)
2" if telescope see back.
 (size)
 - (5) screen none used
 (length) (depth to top)
 (size) (material)
 - (6) pump 1/2 6
 (HP) (yield gpm)
elec
 (type power)
 - (7) electric log no
 (yes or no)
 (organization running log)
 - (8) how well bottom plugged open

4 2' 1 1/4" deep pipe


CODED

DRILLERS REMARKS: _____

AUG 13 1970

If well telescopes please sketch and show depths.

GROUND LEVEL

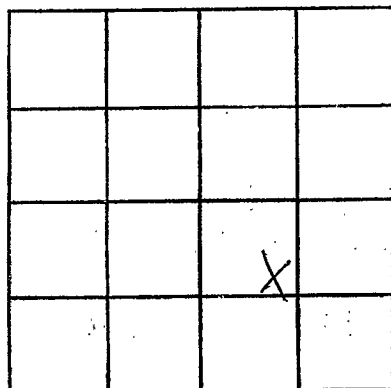

SECTION 36

Please indicate well location X.

ADDITIONAL INFORMATION

If more than one screen,
show locations of each on sketch.