

WAYNE
H127
11-11-70

MISSISSIPPI
BOARD OF WATER COMMISSIONERS
416 North State Street
Jackson, Mississippi 39201

CODED

WATER WELL DRILLERS LOG

NOV. 11 1970 HOLLAND'S WELL SERV. WAYNE
date well completed firm name county well located

LANDOWNER: DAVID M^r NICOLES
Rout 4
WAYNESBORO, MISS.
(mailing address)

description of formations encountered	from	to
RED CLAY	0	12
RED SAND	12	22
WHITE CHALK	22	25
MEDIUM RED SAND	25	40
WHITE CHALK	40	42
WHITE SAND	42	48

WELL LOCATION:
sec. 24 T. 9 S. R. 7 E
5 miles NORTH of WAYNESBORO
(distance) (direction) (nearest town)

WELL PURPOSE: HOME
(home, irrigation, municipal, industrial)

WELL COMPLETION DATA:

(1) diameter (inches) 2"
(2) total depth (feet) 48"
(3) static water level (feet) 30 below top of ground.
(4) casing PLASTIC, 43' (material) (depth)
2" (size) If telescope see back.
(5) screen 5' 43' (length) (depth to top)
2" PLASTIC (size) (material)
(6) pump 1/2 3 (HP) (yield gpm)
ELECT. (type power)
(7) electric log NO (yes or no)
(organization running log)
(8) how well bottom plugged B.W.V.


CODED

NOV 17 1970

DRILLERS REMARKS: MISS. BD. OF WATER COMM.

If well telescopes please sketch and show depths.

GROUND LEVEL

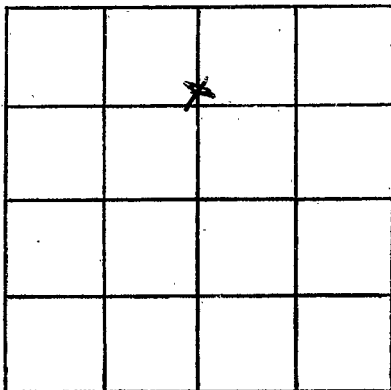

SECTION 24

Please indicate well location X.

ADDITIONAL INFORMATION

If more than one screen, show locations of each on sketch.