

WAYNE
H 128
10-70

MISSISSIPPI
BOARD OF WATER COMMISSIONERS
416 North State Street
Jackson, Mississippi 39201

CODED

WATER WELL DRILLERS LOG

Oct 19 70 Peoples Drilling Co Wayne
date well completed firm name county well located

LANDOWNER: J.P. Dougherty
Rt 1, Box 238
Waynesboro Miss
(mailing address)

description of formations encountered	from	to
Yellow Sandy clay	0	18
Yellow silt clay strata	18	66
Yellow sand	66	20

WELL LOCATION:
sec. 8 T 9 N R 7 E
S W
7 miles NW of WABO
(distance) (direction) (nearest town)

WELL PURPOSE: HOME & chicken for
(home, irrigation, municipal, industrial)

- WELL COMPLETION DATA:
- (1) diameter (inches) 2"
 - (2) total depth (feet) 90'
 - (3) static water level (feet) 78' below
top of ground.
 - (4) casing Galv. 84'
(material) (depth)
2" (size) If telescope see back.
 - (5) screen 6' 84'
(length) (depth to top)
2" stainless steel
(size) (material)
 - (6) pump 1 1/2 15
(HP) (yield gpm)
elect (type power)
 - (7) electric log no
(yes or no)
(organization running log)

CODED

(8) how well bottom plugged Back
wash valve


NOV 23 1970

DRILLERS REMARKS:

MISS. Bd. OF
WATER COM.

If well telescopes please sketch and show depths.

GROUND LEVEL

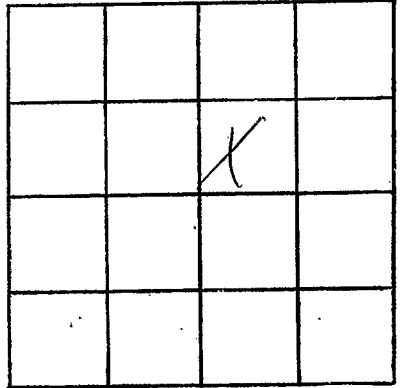

SECTION 8

Please indicate well location X.

ADDITIONAL INFORMATION

If more than one screen,
show locations of each on sketch.