

MISSISSIPPI
BOARD OF WATER COMMISSIONERS
416 North State Street
Jackson, Mississippi 39201

CODED

WATER WELL DRILLERS LOG

WAYNE
H131
3-2-71

March 2 1971 Wayne Drilling, Inc. Wayne
date well completed firm name county well located

LANDOWNER: Jerry Graham
Box 1 Shalata Miss
(mailing address)

WELL LOCATION:
sec. 6 T. 9 N R. 7 E
7 miles NW of Waynesboro
(distance) (direction) (nearest town)

WELL PURPOSE: Home
(home, irrigation, municipal, industrial)

- WELL COMPLETION DATA:
- (1) diameter (inches) 2"
 - (2) total depth (feet) 135'
 - (3) static water level (feet) 101' below top of ground.
 - (4) casing steel 115'
(material) (depth)
2"
(size) If telescope see back.
 - (5) screen iron mesh
(length) (depth to top)
2"
(size) (material)
 - (6) pump 1 1/2 7 1/2
(HP) (yield gpm)
elec
(type power)
 - (7) electric log no
(yes or no)
(organization running log)
 - (8) how well bottom plugged open

description of formations encountered	from	to
<u>red clay</u>	<u>0</u>	<u>15</u>
<u>black & gray</u>	<u>15</u>	<u>20</u>
<u>reddish sand</u>	<u>20</u>	<u>45</u>
<u>blue shale</u>	<u>45</u>	<u>57</u>
<u>blue shale</u>	<u>57</u>	<u>60</u>
<u>black shale</u>	<u>60</u>	<u>115</u>
<u>black shale</u>	<u>115</u>	<u>135</u>

1 1/2" 1 1/2" deep pipe
0 0 0

CODED


MAR 12 1971

MISS. RD. OF
WATER COMM.

DRILLERS REMARKS:

If well telescopes please sketch and show depths.

GROUND LEVEL

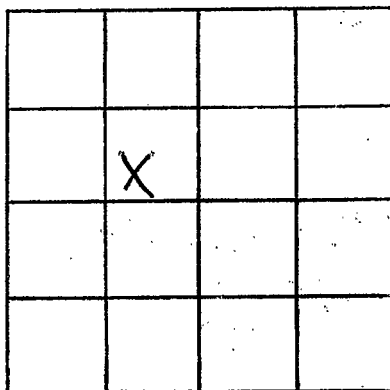

SECTION 6

Please indicate well location X.

ADDITIONAL INFORMATION

If more than one screen, show locations of each on sketch.