

WAYNE

H132

3-9-71

MISSISSIPPI BOARD OF WATER COMMISSIONERS 416 North State Street Jackson, Mississippi 39201

CODED

WATER WELL DRILLERS LOG

March 9 1971 date well completed

Rock Drilling & Supply firm name


Wayne county well located

LANDOWNER: <u>Rebecca Glenn</u>	description of formations encountered	from	to
<u>At 4 Wagon Road or 21st St</u> (mailing address)	<u>red clay</u>	<u>0</u>	<u>15</u>
WELL LOCATION: sec. <u>1</u> T. <u>90</u> N. R. <u>7</u> E. S. <u>7</u> W. <u>7</u> miles N of <u>Waynes</u> (distance) (direction) (nearest town)	<u>part of clay</u>	<u>15</u>	<u>51</u>
WELL PURPOSE: <u>Home</u> (home, irrigation, municipal, industrial)	<u>part of clay</u>	<u>51</u>	<u>54</u>
WELL COMPLETION DATA: (1) diameter (inches) <u>2"</u> (2) total depth (feet) <u>126'</u> (3) static water level (feet) <u>97</u> (below/above top of ground) (4) casing <u>steel</u> <u>115'</u> (material) (depth) <u>2"</u> if telescope see back. (size) (5) screen <u>5'</u> <u>121'</u> (length) (depth to top) <u>1/4"</u> <u>galv. S.S.</u> (size) (material) (6) pump <u>2</u> <u>8 1/2</u> (HP) (yield gpm) <u>elec.</u> (type power) (7) electric log <u>no</u> (yes or no)  (organization running log)	<u>part of clay</u>	<u>54</u>	<u>78</u>
	<u>sand</u>	<u>78</u>	<u>126</u>
	<u>5' 1/4' galv. S.S.</u>		
	<u>with 7' 1/4' cap. bit</u>		
	<u>in with reamer</u>		
	<u>105 1/4' drop pipe</u>		
	<u>0 1'</u>		
	<u>CODED</u>		
	<u>APR - 8 1971</u>		
DRILLERS REMARKS: <u>How well bottom plugged</u> <u>plugged</u>			

MISS. DIV. OF WATER CONTROL

If well telescopes please sketch and show depths.

GROUND LEVEL

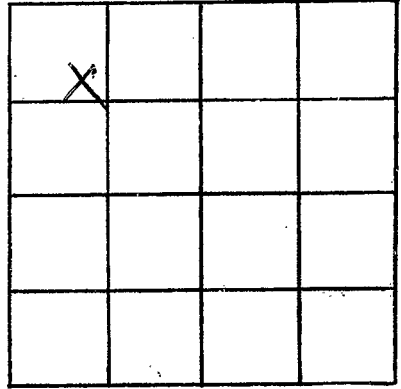

SECTION /

Please indicate well location X.

ADDITIONAL INFORMATION

If more than one screen,  
show locations of each on sketch.