

WAYNE  
H 133  
5-5-71

MISSISSIPPI  
BOARD OF WATER COMMISSIONERS  
416 North State Street  
Jackson, Mississippi 39201

**CODED**

WATER WELL DRILLERS LOG

May 5 1971 HOLLAND'S WATER WELL SERV WAYNE  
date well completed firm name county well located

LANDOWNER: GERALD LOPPER  
Root 1  
WAYNESBORO, MISS.  
(mailing address)

description of formations encountered	from	to
TOP SOIL	0	1
YELLOW CLAY	1	4
MEDIUM RED SAND	4	93
SOFT LIME ROCK	93	96
MED. LIGHT WATER SAND	96	127

WELL LOCATION:  
sec. 30 T. 9 S. R. 7 E.  
5 miles N of WAYNESBORO  
(distance) (direction) (nearest town)

WELL PURPOSE: HOME  
(home, irrigation, municipal, industrial)

- WELL COMPLETION DATA:
- (1) diameter (inches) 2"
  - (2) total depth (feet) 127'
  - (3) static water level (feet) 106' <sup>below</sup> above top of ground.
  - (4) casing PLASTIC, 120'  
(material) (depth)
  - 2" If telescope see back.  
(size)
  - (5) screen 6', 121'  
(length) (depth to top)
  - 1 1/2", PLASTIC  
(size) (material)
  - (6) pump 1 3  
(HP) (yield gpm)
  - ELECT  
(type power)
  - (7) electric log NO  
(yes or no)

(organization running log)  
(8) how well bottom plugged Bitum  
PLUG

DRILLERS REMARKS:


**CODED**

MAY 21 1971

MISS. Bd. OF  
WATER COMMISSIONERS

If well telescopes please sketch and show depths.

GROUND LEVEL

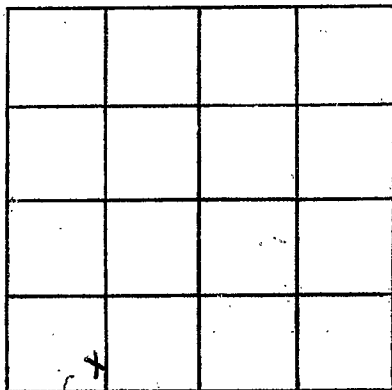

SECTION 20

Please indicate well location X.

ADDITIONAL INFORMATION

If more than one screen,  
show locations of each on sketch.