

WAYNE  
H 135  
6-16-71

MISSISSIPPI  
BOARD OF WATER COMMISSIONERS  
416 North State Street  
Jackson, Mississippi 39201

**CODED**

WATER WELL DRILLERS LOG

June 16 1971 Robert Dillingham, Wayne  
date well completed firm name county well located

LANDOWNER: <u>W. M. Walker</u>	description of formations encountered	from	to
<u>At 1 Hammershire Miss</u> (mailing address)			
	<u>blue chert</u>	<u>21</u>	<u>44</u>
	<u>blue chalk</u>	<u>44</u>	<u>63</u>
	<u>thin corals</u>	<u>63</u>	<u>63</u>
	<u>blue chalk</u>	<u>63</u>	<u>73</u>
	<u>soft rock &amp; Chalk</u>	<u>73</u>	<u>78</u>
	<u>1/2" chert</u>	<u>78</u>	<u>106</u>
WELL LOCATION: sec. <u>34</u> T. <u>9</u> N. R. <u>7</u> E. <u>2</u> miles <u>NW</u> of <u>Hammershire</u> (distance) (direction) (nearest town)			
WELL PURPOSE: <u>home</u> (home, irrigation, municipal, industrial)			
WELL COMPLETION DATA: (1) diameter (inches) <u>2"</u>			
(2) total depth (feet) <u>106'</u>			
(3) static water level (feet) <u>30'</u> below top of ground.			
(4) casing <u>steel</u> <u>79'</u> (material) (depth)			
<u>2"</u> (size) if telescope see back.			
(5) screen <u>none used</u> (length) (depth to top)			
(size) (material)			
(6) pump <u>3/4</u> <u>10</u> (HP) (yield gpm)			
<u>elec</u> (type power)			
(7) electric log <u>no</u> (yes or no)			
(organization running log)			
(8) how well bottom plugged			
DRILLERS REMARKS:			


**CODED**

JUL 14 1971

MISSISSIPPI BOARD OF WATER COMMISSIONERS

If well telescopes please sketch and show depths.

GROUND LEVEL

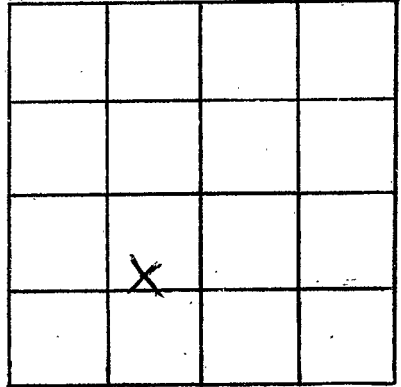

SECTION 34

Please indicate well location X.

ADDITIONAL INFORMATION

If more than one screen,  
show locations of each on sketch.