

WAYNE  
H 136  
7-10-71

MISSISSIPPI  
BOARD OF WATER COMMISSIONERS  
416 North State Street  
Jackson, Mississippi 39201

**CODED**

WATER WELL DRILLERS LOG

July 10 1971 Boater Drilling & Log Wayne  
date well completed firm name county well located

LANDOWNER A. V. Henry description of formations encountered from to

At 42 Magnolia Ave  
(mailing address)

WELL LOCATION:

sec. 1 T. 90 N. R. 7 E  
S W  
7 miles N of Waynesboro  
(distance) (direction) (nearest town)

WELL PURPOSE: home  
(home, irrigation, municipal, industrial)

WELL COMPLETION DATA:

- (1) diameter (inches) 2"
- (2) total depth (feet) 121
- (3) static water level (feet) 100 (below above top of ground)
- (4) casing steel 112'  
(material) (depth)
- 2" if telescope see back.  
(size)
- (5) screen 5' 116'  
(length) (depth to top)
- 1/4" belt SS.  
(size) (material)
- (6) pump 2 10  
(HP) (yield gpm)
- elec  
(type power)
- (7) electric log no  
(yes or no)

(organization running log)

(8) how well bottom plugged plugged

DRILLERS REMARKS:

red clay  
sand  
rock  
chalk  
chalk  
sand & chalk  
med sand  
shovel in sand  
back getting finer

5' 1/4" belt SS with  
5' 1/4" log pipe hat  
in well packer  
105' 1/4" drop pipe


**CODED**

FORM T-4 1971

MISS. Bd. of  
WATER COMMISSIONERS

If well telescopes please sketch and show depths.

GROUND LEVEL

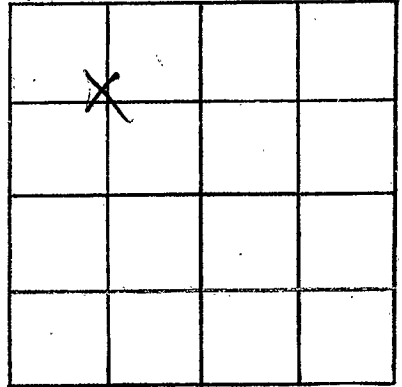

SECTION 1

Please indicate well location X.

ADDITIONAL INFORMATION

If more than one screen, show locations of each on sketch.