

MISSISSIPPI  
BOARD OF WATER COMMISSIONERS  
416 North State Street  
Jackson, Mississippi 39201

**CODED**

WATER WELL DRILLERS LOG

WAYNE  
H-137  
8-71

Ceng 19 71 Peoples Drilling Co. Wayne  
date well completed firm name county well located

LANDOWNER: Marshall McNickel  
Rt 4 Box 2820  
Waynesboro, Miss  
(mailing address)

WELL LOCATION:  
sec. 13 T. 9 N. R. 7 E.  
5 miles N of Waynesboro  
(distance) (direction) (nearest town)

WELL PURPOSE: HOME  
(home, irrigation, municipal, industrial)

WELL COMPLETION DATA:

- (1) diameter (inches) 2"
- (2) total depth (feet) 89'
- (3) static water level (feet) 62 below top of ground.
- (4) casing Galv., 84',  
(material) (depth)  
2" if telescope see back.  
(size)
- (5) screen 5', 84'  
(length) (depth to top)  
2 5/8", stainless  
(size) (material)
- (6) pump 1 10  
(HP) (yield gpm)  
electric  
(type power)
- (7) electric log no  
(yes or no)  
(organization running log)
- (8) how well bottom plugged Back  
with valve

description of formations encountered	from	to
<u>Yellow clay</u>	<u>0</u>	<u>18</u>
<u>yellow sand clay</u>	<u>18</u>	<u>36</u>
<u>yellow sand clay</u> <u>&amp; sand streak</u>	<u>36</u>	<u>63</u>
<u>yellow sand</u> <u>underlay streak</u>	<u>63</u>	<u>85'</u>
<u>Cavity (sand)</u>	<u>85</u>	<u>89</u>

**CODED**


SEP 10 1971

MISS. BD. OF  
WATER COMM.

DRILLERS REMARKS:

If well telescopes please sketch and show depths.

GROUND LEVEL

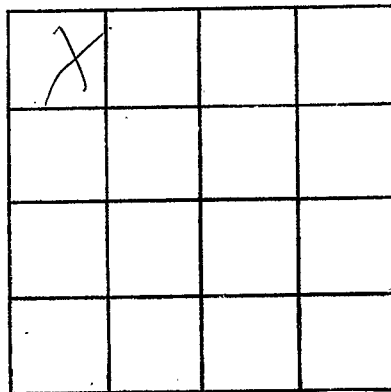

SECTION 13

Please indicate well location X.

ADDITIONAL INFORMATION

If more than one screen, show locations of each on sketch.