

Wayne  
H 141  
1-27-72

MISSISSIPPI  
BOARD OF WATER COMMISSIONERS  
416 North State Street  
Jackson, Mississippi 39201

WATER WELL DRILLERS LOG

CODED

1-27 1972 Card water well down Wayne  
date well completed firm name county well located

LANDOWNER: Dennis Clark  
Waynesboro Mill  
(mailing address)

description of formations encountered	from	to
TOP SOIL	0	2
Red SANDY CLAY	2	8
Pink + white CLAY	8	15
COARSE yellow SAND	15	40
COARSE white SAND	40	50
PEA GRAVEL	50	54
COARSE white SAND	54	56
PEA GRAVEL	56	74

WELL LOCATION:  
sec. 21 T. 9 N. R. 7 E. S. W  
2 miles ENE of WAYNESBORO  
(distance) (direction) (nearest town)

WELL PURPOSE: HOME  
(home, irrigation, municipal, industrial)

- WELL COMPLETION DATA:
- (1) diameter (inches) 4" x 2"
  - (2) total depth (feet) 74
  - (3) static water level (feet) 55 <sup>below</sup> / <sub>above</sub> top of ground.
  - (4) casing PVC, 69 (material) (depth)  
(size) if telescope see back.
  - (5) screen 5', 69 (length) (depth to top)  
2", PVC (10 slot) (size) (material)
  - (6) pump 1 (HP) 10 (yield gpm)  
Elect (type power)
  - (7) electric log No (yes or no)  
(organization running log)
  - (8) how well bottom plugged 2" B.W.V.

CODED


JAN 31 1972

MISS. Bd. of  
WATER COMMA

DRILLERS REMARKS:

If well telescopes please sketch and show depths.

GROUND LEVEL

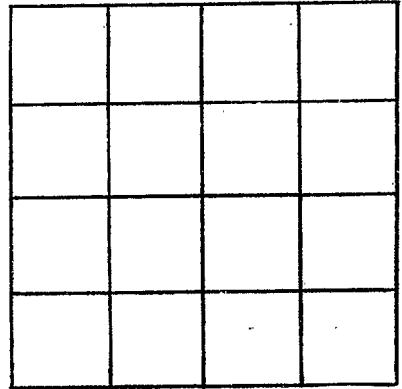

SECTION \_\_\_\_\_

Please indicate well location X.

ADDITIONAL INFORMATION

If more than one screen,  
show locations of each on sketch.