

WAYNE
H 143
4-12-72

MISSISSIPPI
BOARD OF WATER COMMISSIONERS
416 North State Street
Jackson, Mississippi 39201

WATER WELL DRILLERS LOG

CODED

April 12 1972 Porter Drilling & Supply Wayne
 (date well completed) (firm name) (county well located)

LANDOWNER: Cissie Hayes

Box 4 Waynesboro Miss
 (mailing address)

WELL LOCATION:
 sec. 1 T. 9 N. R. 7 E. S. 5 W. 10
7 1/2 miles N of Waynesboro
 (distance) (direction) (nearest town)

WELL PURPOSE: Home
 (home, irrigation, municipal, industrial)

- WELL COMPLETION DATA:
- (1) diameter (inches) 2"
 - (2) total depth (feet) 125'
 - (3) static water level (feet) 90 (below above top of ground.)
 - (4) casing steel 113'
 (material) (depth)
2" (size) if telescope see back.
 - (5) screen 5' 120
 (length) (depth to top)
1 1/2" (size) 6 slot S.S. (material)
 - (6) pump 2 8 1/2
 (HP) (yield gpm)
elec. (type power)
 - (7) electric log no
 (yes or no)
- (organization running log)

description of formations encountered	from	to
<u>sand & chalk</u>	<u>0</u>	<u>51</u>
<u>thin rock</u>		<u>51</u>
<u>sand & chalk</u>	<u>51</u>	<u>118</u>
<u>fine sand</u>	<u>118</u>	<u>125</u>
<u>rest of on chalk</u>		
<u>5' 1/2" 6 slot S.S. with</u>		
<u>8' 1/2" 1/2" pipe twist</u>		
<u>in with 1/2" hole</u>		
<u>105' 1 1/4" drag pipe</u>		

CODED

MAY 12 1972


MISS. RD. OF
 WATER COM. **MISS.**

(8) how well bottom plugged flush ground

DRILLERS REMARKS:

If well telescopes please sketch and show depths.

GROUND LEVEL

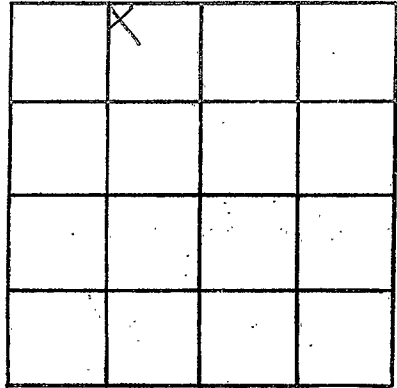

SECTION /

Please indicate well location X.

ADDITIONAL INFORMATION

If more than one screen, show locations of each on sketch.