

WAYNE
H 145
6-8-72

77
MISSISSIPPI
BOARD OF WATER COMMISSIONERS
416 North State Street
Jackson, Mississippi 39201

WATER WELL DRILLERS LOG

June 8 1972 Bob Drilling Co Wayne
date well completed firm name county well located


LANDOWNER: <u>Joan Stanley</u>	description of formations encountered	from	to
<u>2142 Wagnersboro Miss</u> (mailing address)	<u>Clay</u> <u>Chalk & sand</u> <u>sand</u> <u>stop on chalk</u>	<u>0</u>	<u>15</u> <u>15</u> <u>30</u> <u>37</u>
WELL LOCATION: sec <u>11</u> T <u>9N</u> R <u>7</u> E <u>5</u> miles <u>N</u> of <u>Wagnersboro</u> (distance) (direction) (nearest town)			
WELL PURPOSE: <u>drone</u> (home, irrigation, municipal, industrial)			
WELL COMPLETION DATA: (1) diameter (inches) <u>2"</u> (2) total depth (feet) <u>37'</u> (3) static water level (feet) <u>27</u> <small>(below above top of ground)</small> (4) casing <u>steel</u> <u>33'</u> (material) (depth) <u>2"</u> If telescope see back. (size) (5) screen <u>3'</u> <u>33'</u> (length) (depth to top) <u>1 1/2</u> <u>7 shot SS.</u> (size) (material) (6) pump <u>1/2</u> <u>7 1/2</u> (HP) (yield.gpm) <u>elec.</u> (type power) (7) electric log <u>no</u> (yes or no) (organization running log)			
(8) how well bottom plugged <u>back work valve</u>			
DRILLERS REMARKS:			

31' 1 1/4" drop gauge
3' 1 1/4" 7 shot SS with
1 1/4" back work valve
screwed on end of
Casing.

JUN 27 1972

If well telescopes please sketch and show depths.

GROUND LEVEL

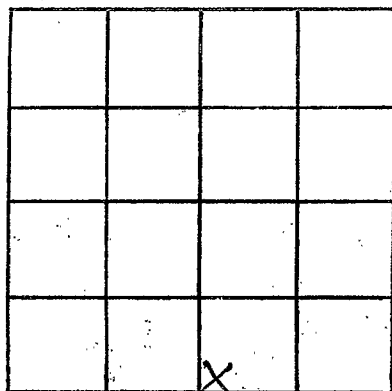

SECTION 11

Please indicate well location X.

ADDITIONAL INFORMATION

A series of horizontal lines for writing additional information.

If more than one screen, show locations of each on sketch.