

**MISSISSIPPI
BOARD OF WATER COMMISSIONERS**
416 North State Street
Jackson, Mississippi 39201

CODED

WATER WELL DRILLERS LOG

Wayne
H146
8-30-72

Aug 30 1972 Center Drilling, Inc Wayne
date well completed firm name county well located

LANDOWNER: Virgil Powell
At 1 Waynesboro, Miss
(mailing address)

description of formations encountered	from	to
<u>red clay</u>	<u>0</u>	<u>10</u>
<u>sand & chalk</u>	<u>10</u>	<u>45</u>
<u>sand</u>	<u>45</u>	<u>60</u>
<u>chalk</u>	<u>60</u>	<u>114</u>
<u>rock stratum</u>	<u>114</u>	<u>153</u>
<u>chalk</u>	<u>153</u>	<u>194</u>
<u>limestone rock</u>	<u>194</u>	<u>219</u>

WELL LOCATION:
32 sec. 7 T. 9 N. R. 7 E. W
4 miles W. of Waynesboro
(distance) (direction) (nearest town)

WELL PURPOSE: home
(home, irrigation, municipal, industrial)

- WELL COMPLETION DATA:
- (1) diameter (inches) 2"
 - (2) total depth (feet) 219'
 - (3) static water level (feet) 110 below top of ground. above
 - (4) casing steel, 194'
(material) (depth)
2" If telescope see back.
(size)
 - (5) screen none used
(length) (depth to top)
(size) (material)
 - (6) pump 2 5
(HP) (yield gpm)
elec
(type power)
 - (7) electric log no
(yes or no)
(organization running log)
 - (8) how well bottom plugged open

147' 1 1/4" drop pipe

CODED


SEP 13 1972

DRILLERS REMARKS:

MISS. BD. O.
WATER BOARD

If well telescopes please sketch and show depths.

GROUND LEVEL

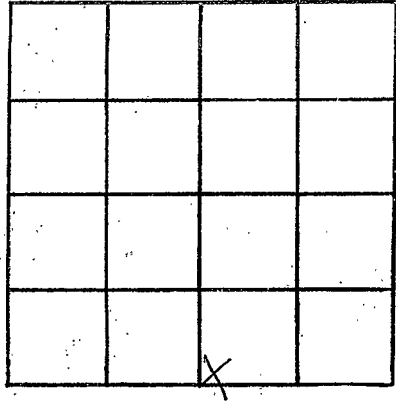

SECTION 32

Please indicate well location X.

ADDITIONAL INFORMATION

If more than one screen, show locations of each on sketch.