

**MISSISSIPPI
BOARD OF WATER COMMISSIONERS**
416 North State Street
Jackson, Mississippi 39201

CODED

WATER WELL DRILLERS LOG

WAYNE

H 148

1-5-73

date well completed Jan 5 1973 firm name Boyle Drilling Co county well located Wayne

LANDOWNER: Dr. Allen Williams

description of formations encountered

from to

At 4 Maryestown Miss
(mailing address)

<u>red clay & chalk</u>	<u>0</u>	<u>20</u>
<u>blue rock</u>	<u>20</u>	<u>25</u>
<u>red strata</u>	<u>25</u>	<u>65</u>
<u>blue chalk</u>	<u>65</u>	<u>67</u>
<u>sand</u>	<u>67</u>	<u>109</u>
<u>Tricksburg</u>	<u>109</u>	<u>136</u>

WELL LOCATION:

sec 36 T 9 (N) R 7 (E) (W)
1 1/2 miles N of Maryestown
(distance) (direction) (nearest town)

WELL PURPOSE: Home
(home, irrigation, municipal, industrial)

84' 1 1/4" diameter pipe

WELL COMPLETION DATA:

- (1) diameter (inches) 3"
- (2) total depth (feet) 136'
- (3) static water level (feet) 71 (below/above top of ground)
- (4) casing steel, 109' (material) (depth)
2" (size) if telescope see back.
- (5) screen none used (length) (depth to top)
(size) (material)
- (6) pump 1 (HP) 10 (yield gpm)
elec (type power)
- (7) electric log no (yes or no)

(organization running log)


(8) how well bottom plugged open

JAN 10 1973

DRILLERS REMARKS:

If well telescopes please sketch and show depths.

GROUND LEVEL

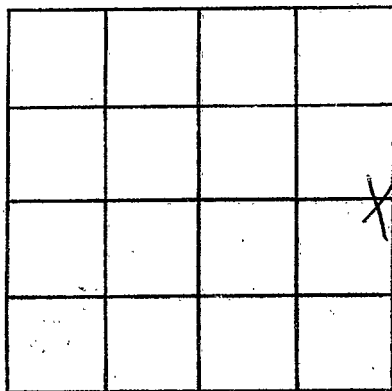

SECTION 36

Please indicate well location X.

ADDITIONAL INFORMATION

If more than one screen,
show locations of each on sketch.