

WAYNE
H 149
1-73

MISSISSIPPI
BOARD OF WATER COMMISSIONERS
416 North State Street
Jackson, Mississippi 39201

CODED

WATER WELL DRILLERS LOG

19 McILWAIN Water Well Ser WAYNE

date well completed

firm name

county well located

LANDOWNER:
J. P. DAUGHERTY
Rt 1 WAYNESBORO
(mailing address)

description of formations encountered	from	to
<u>Red Clay</u>	<u>0</u>	<u>3</u>
<u>Sand</u>	<u>3</u>	<u>55</u>
<u>sand + clay streaks</u>	<u>55</u>	<u>70</u>
<u>Coarse sand</u>	<u>70</u>	<u>74</u>
<u>sand + clay streaks</u>	<u>74</u>	<u>80</u>
<u>Sand</u>	<u>80</u>	<u>90</u>

WELL LOCATION:
sec 8 T 9 N R 7 E
9 miles NW of W'BORO
(distance) (direction) (nearest town)

WELL PURPOSE: Home
(home, irrigation, municipal, industrial)

- WELL COMPLETION DATA:
- (1) diameter (inches) 2"
 - (2) total depth (feet) 90
 - (3) static water level (feet) 73 below top of ground.
 - (4) casing PVC 80
(material) (depth)
2" If telescope see back.
(size)
 - (5) screen 10' 80'
(length) (depth to top)
2" PVC .008
(size) (material)
 - (6) pump 1 6
(HP) (yield gpm)
110 AC
(type power)
 - (7) electric log NO
(yes or no)
- (organization running log)
- (8) how well bottom plugged


CODED

7/27 9/3

DRILLERS REMARKS:

If well telescopes please sketch and show depths.

GROUND LEVEL

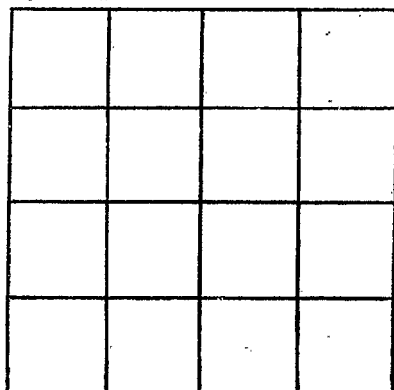

SECTION _____

Please indicate well location X.

ADDITIONAL INFORMATION

If more than one screen, show locations of each on sketch.