

Wayne  
H 150  
1-15-73

MISSISSIPPI  
BOARD OF WATER COMMISSIONERS  
416 North State Street  
Jackson, Mississippi 39201

**CODED**

WATER WELL DRILLERS LOG

1-15-73 date well completed      19 M<sup>rs</sup> ILWAIN WATER WELL SER. firm name      WAYNE county well located

LANDOWNER:	description of formations encountered	from	to
<u>Tommy Holifield</u>			
<u>Rt 1 Waynesboro, Miss.</u> (mailing address)	<u>White chalk</u>	<u>11</u>	<u>14</u>
WELL LOCATION: sec. <u>33</u> T <u>9</u> N R <u>7</u> W <u>3</u> miles <u>NW</u> of <u>W'BORO</u> (distance) (direction) (nearest town)	<u>Sand</u>	<u>14</u>	<u>40</u>
WELL PURPOSE: <u>HOME</u> (home, irrigation, municipal, industrial)			
WELL COMPLETION DATA: (1) diameter (inches) <u>2"</u> (2) total depth (feet) <u>41</u> (3) static water level (feet) <u>25</u> below top of ground. (4) casing <u>PVC</u> <u>36'</u> (material) (depth) <u>2"</u> if telescope see back. (size) (5) screen <u>5'</u> <u>36'</u> (length) (depth to top) <u>2"</u> <u>PVC .009</u> (size) (material) (6) pump <u>1</u> <u>5.5</u> (HP) (yield gpm) <u>110 AC</u> (type power) (7) electric log <u>no</u> (yes or no) (organization running log) (8) how well bottom plugged _____ DRILLERS REMARKS: _____			


**CODED**

FEB 7 1973

MISC

If well telescopes please sketch and show depths.

GROUND LEVEL

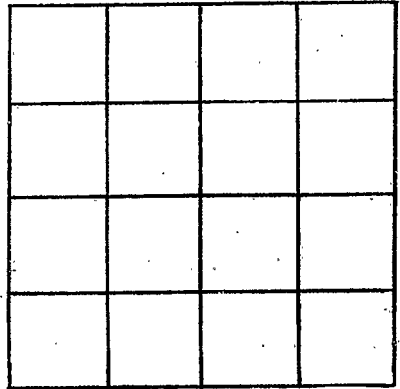

SECTION \_\_\_\_\_

Please indicate well location X.

ADDITIONAL INFORMATION

If more than one screen,  
show locations of each on sketch.