

BOARD OF WATER COMMISSIONERS
416 North State Street
Jackson, Mississippi 39201

WAYNE

H 151

1-19-73

WATER WELL DRILLERS LOG

Jan 19 1973 Pro. Drilling & Pump Wayne
date well completed firm name county well located

LANDOWNER: Mr Harry Shirley

description of formations encountered	from to	
<u>clay & sand</u>	<u>0</u>	<u>15</u>
<u>sand & shell</u>	<u>15</u>	<u>30</u>
<u>sand</u>	<u>30</u>	<u>44</u>
<u>shale & white shell in sand</u>		

At 11 Magnesonboro
(mailing address)

WELL LOCATION:
sec 33 T 9 (N) R 7 (E)
3 miles NW of Magnesonboro
(distance) (direction) (nearest town)

WELL PURPOSE: Home
(home, irrigation, municipal, industrial)

WELL COMPLETION DATA:

- (1) diameter (inches) 2"
- (2) total depth (feet) 44'
- (3) static water level (feet) 26 (below above top of ground)
- (4) casing steel 40'
(material) (depth)
2' if telescope see back.
(size)
- (5) screen 3' 41'
(length) (depth to top)
1 1/4" below ss.
(size) (material)
- (6) pump 5 5
(HP) (yield gpm)
elec
(type power)
- (7) electric log no
(yes or no)
(organization running log)
- (8) how well bottom plugged flush ground

3' 1 1/4" below ss.
with 1 1/2" 1 1/2" log pipe
short in well footer
38' 1 1/4" charge pipe


CODED

FEB 20 1973

DRILLERS REMARKS:

If well telescopes please sketch and show depths.

GROUND LEVEL

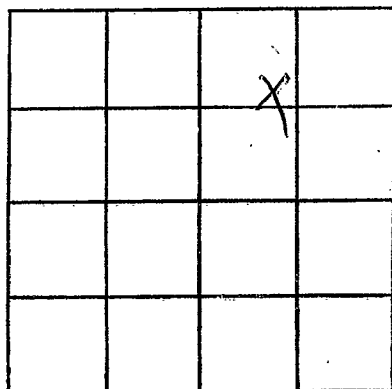

SECTION 33

Please indicate well location X.

ADDITIONAL INFORMATION

If more than one screen,
show locations of each on sketch.