

WELL # 2

MISSISSIPPI
BOARD OF WATER COMMISSIONERS
416 North State Street
Jackson, Mississippi 39201

CODED

WATER WELL DRILLERS LOG

WAYNE
H 153
2-16-73

3-16 1973 JR. GREEN WATERWELL DRILLERS WAYNE
date well completed firm name county well located

LANDOWNER:	description of formations encountered	from	to
JOHN C. LEE	RED CLAY	0	10
R1 BOX 255 WAYNESBORO MISS (mailing address) 39367	WHITE SAND	10	20
	" "	20	22
	WHITE CHALK	22	

WELL LOCATION:
sec. 35 T 9 N R 7 E W
3 miles NORTH of WAYNESBORO
(distance) (direction) (nearest town)

WELL PURPOSE: BROILER HOUSE
(home, irrigation, municipal, industrial)

- WELL COMPLETION DATA:
- (1) diameter (inches) 4
 - (2) total depth (feet) 22
 - (3) static water level (feet) 14 below top of ground.
 - (4) casing PVC 17
(material) (depth)
if telescope see back.
(size)
 - (5) screen 5' 17
(length) (depth to top)
2" 008 PVC
(size) (material)
 - (6) pump 1/2 8
(HP) (yield gpm)
220 VAC
(type power)
 - (7) electric log No
(yes or no)
(organization running log)
 - (8) how well bottom plugged


CODED

MAR 6 1973

DRILLERS REMARKS:

If well telescopes please sketch and show depths.

GROUND LEVEL

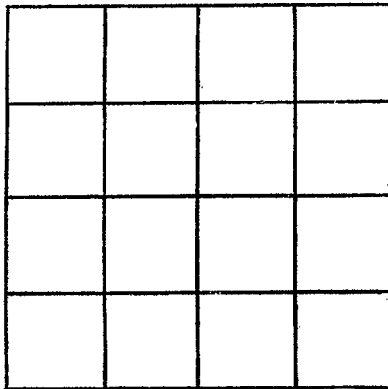

SECTION 35

Please indicate well location X.

ADDITIONAL INFORMATION

A series of horizontal lines for entering additional information.

If more than one screen, show locations of each on sketch.