

WAYNE
H 154
4-20-73

MISSISSIPPI
BOARD OF WATER COMMISSIONERS
416 North State Street
Jackson, Mississippi 39201

CODED

WATER WELL DRILLERS LOG


4-20-73 19 MS. ILWAIN WATER WELL SER. WAYNE
date well completed firm name county well located

LANDOWNER:	description of formations encountered	from	to
JIMMIE SHIRLEY			
RT 1 WAYNESBORO (mailing address)	CLAY	6	11
WELL LOCATION:	SAND	11	13
sec. 33 T 9 N R 7 W	CLAY	13	14
3 miles N-W of W' BORO (distance) (direction) (nearest town)	SAND & CLAY	14	18
WELL PURPOSE: HOME (home, irrigation, municipal, industrial)	FINE SAND	18	22
WELL COMPLETION DATA:	MED. SAND	22	25
(1) diameter (inches) 2"	COARSE SAND	25	41
(2) total depth (feet) 41'			
(3) static water level (feet) 17' below top of ground.			
(4) casing PVC 36' (material) (depth)			
2" if telescope see back. (size)			
(5) screen 5' 36' (length) (depth to top)			
1/4 STAINLESS S. 008 (size) (material)			
(6) pump 1 12 (HP) (yield gpm)			
220 AC (type power)			
(7) electric log NO (yes or no)			
(organization running log)			
(8) how well bottom plugged			
DRILLERS REMARKS:			

CODED

If well telescopes please sketch and show depths.

GROUND LEVEL

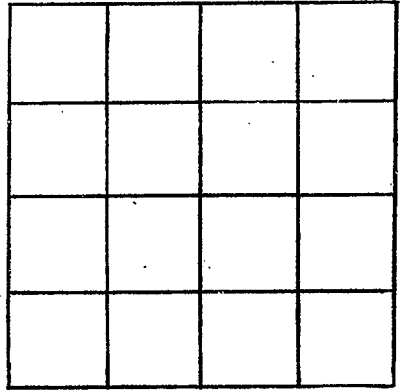

SECTION _____

Please indicate well location X.

ADDITIONAL INFORMATION

If more than one screen,
show locations of each on sketch.