

MISSISSIPPI
BOARD OF WATER COMMISSIONERS
416 North State Street
Jackson, Mississippi 39201

CODED

WAYNE
H 155
6-1-73

WATER WELL DRILLERS LOG

June 1 1973 date well completed
Booth Drilling & Log firm name
Wayne county well located

LANDOWNER: J. W. Booth

description of formations encountered

from

to

Box 4 Waynesboro (mailing address)

10' clay
10' sand
rest part in chalk

WELL LOCATION:

sec. 25 T 90 N R 7 E S W
2 miles N of Waynesboro (distance) (direction) (nearest town)

5' 1 1/2" 1" shot S.S.
with 18" 1 1/2" drop gauge
burst in with geacher

WELL PURPOSE: Home (home, irrigation, municipal, industrial)

WELL COMPLETION DATA:

(1) diameter (inches) 2"
(2) total depth (feet) 42'
(3) static water level (feet) 22' below top of ground.

35' 1 1/4" drop gauge

(4) casing 37' steel (material) (depth)
2" If telescope see back. (size)

(5) screen 5' 37' (length) (depth to top)
1 1/4" shot S.S. (size) (material)

CODED

(6) pump 1 8 1/2 (HP) (yield gpm)
elec. (type power)

(7) electric log no (yes or no)
(organization running log)


(8) how well bottom plugged
1/2" shot S.S.

DRILLERS REMARKS:

JUN 5 1973

If well telescopes please sketch and show depths.

GROUND LEVEL

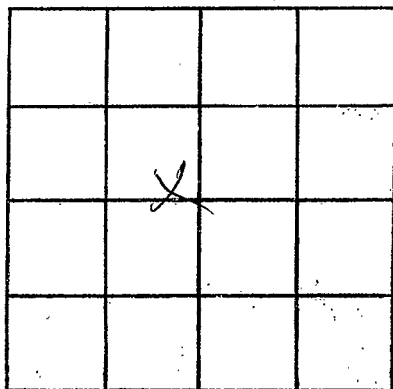

SECTION 25

Please indicate well location X.

ADDITIONAL INFORMATION

If more than one screen,
show locations of each on sketch.