

WAYNE  
H 157  
6-1-73

MISSISSIPPI  
BOARD OF WATER COMMISSIONERS  
416 North State Street  
Jackson, Mississippi 39201

**CODED**

WATER WELL DRILLERS LOG

June 1 1973 date well completed  
Pete Drilling & Log firm name  
Wayne county well located

LANDOWNER: Stanley D. Kelly

description of formations encountered

from

to

111 Magneshoro  
(mailing address)

meat clay	0	13
red loam sand	13	45
meat sand	45	63
sand & red chalk	63	65
red part of chalk		

WELL LOCATION:

sec. 8 T 9 N R 7  
S W  
6 miles NW of Waynesboro  
(distance) (direction) (nearest town)

WELL PURPOSE: home  
(home, irrigation, municipal, industrial)

5' 1 1/2" basket S.S.  
removed on end of case

WELL COMPLETION DATA:

- diameter (inches) 2"
- total depth (feet) 65
- static water level (feet) 41 (below/above top of ground)
- casing steel 53  
(material) (depth)  
2 if telescope see back.  
(size)
- screen 5' 58'  
(length) (depth to top)  
1/2" basket S.S.  
(size) (material)
- pump 1 12  
(HP) (yield gpm)  
elec  
(type power)
- electric log no  
(yes or no)

5' x 1 1/4" drive pipe

**CODED**

(organization running log)

(8) how well bottom plugged: plank ground


DRILLERS REMARKS:

JUN 5 1973

MISS. RD. 11  
WATER 11

If well telescopes please sketch and show depths.

GROUND LEVEL

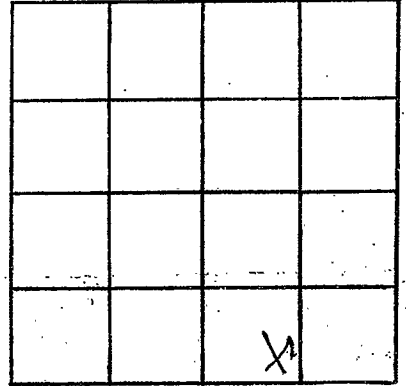

SECTION 8

Please indicate well location X.

ADDITIONAL INFORMATION

If more than one screen,  
show locations of each on sketch.