

WAYNE  
H 159  
9-8-73

MISSISSIPPI  
BOARD OF WATER COMMISSIONERS  
416 North State Street  
Jackson, Mississippi 39201

**CODED**

WATER WELL DRILLERS LOG

Sept 8, 73 19 McILWAIN WATER WELL SERVICE WAYNE  
date well completed RT. 2, m BOX 37 county well located  
WAYNESBORO

LANDOWNER:  
JAMES CLEMENTS  
RT 1 WAYNESBORO  
(mailing address)

description of formations encountered	from	to
	RED CLAY	0
RED SAND	5	43
CLAY	43	49
SAND	49	75

WELL LOCATION:  
sec. 2 T. 9<sup>N</sup> R. 7<sup>E</sup>  
7 miles NW of W BORO  
(distance) (direction) (nearest town)

WELL PURPOSE: HOME  
(home, irrigation, municipal, industrial)

**CODED**


- WELL COMPLETION DATA:
- (1) diameter (inches) 2"
  - (2) total depth (feet) 75'
  - (3) static water level (feet) 53' below top of ground.
  - (4) casing PVC 65' (material) (depth)  
2" (size) if telescope see back.
  - (5) screen 10' 65' (length) (depth to top)  
2" PVC .008 (size) (material)
  - (6) pump 1 10 (HP) (yield gpm)  
110 AC (type power)
  - (7) electric log NO (yes or no)  
(organization running log)
  - (8) how well bottom plugged

DRILLERS REMARKS:

SEP 10 1973

If well telescopes please  
sketch and show depths.

GROUND LEVEL

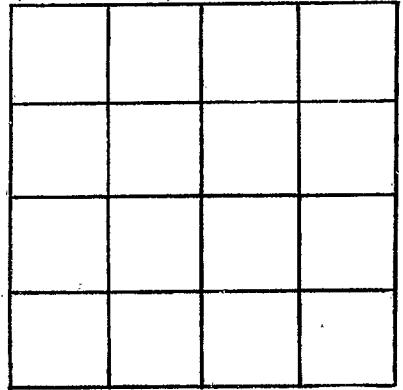

SECTION \_\_\_\_\_

Please indicate well location X.

ADDITIONAL INFORMATION

If more than one screen,  
show locations of each on sketch.